


17090

\*\* RECEIVED \*\*  
 Date 10-8-01 By DB  
 This survey Consists of:  
 / sheet(s) Map  
 / page(s) Narrative  
 JACKSON COUNTY  
 SURVEYOR

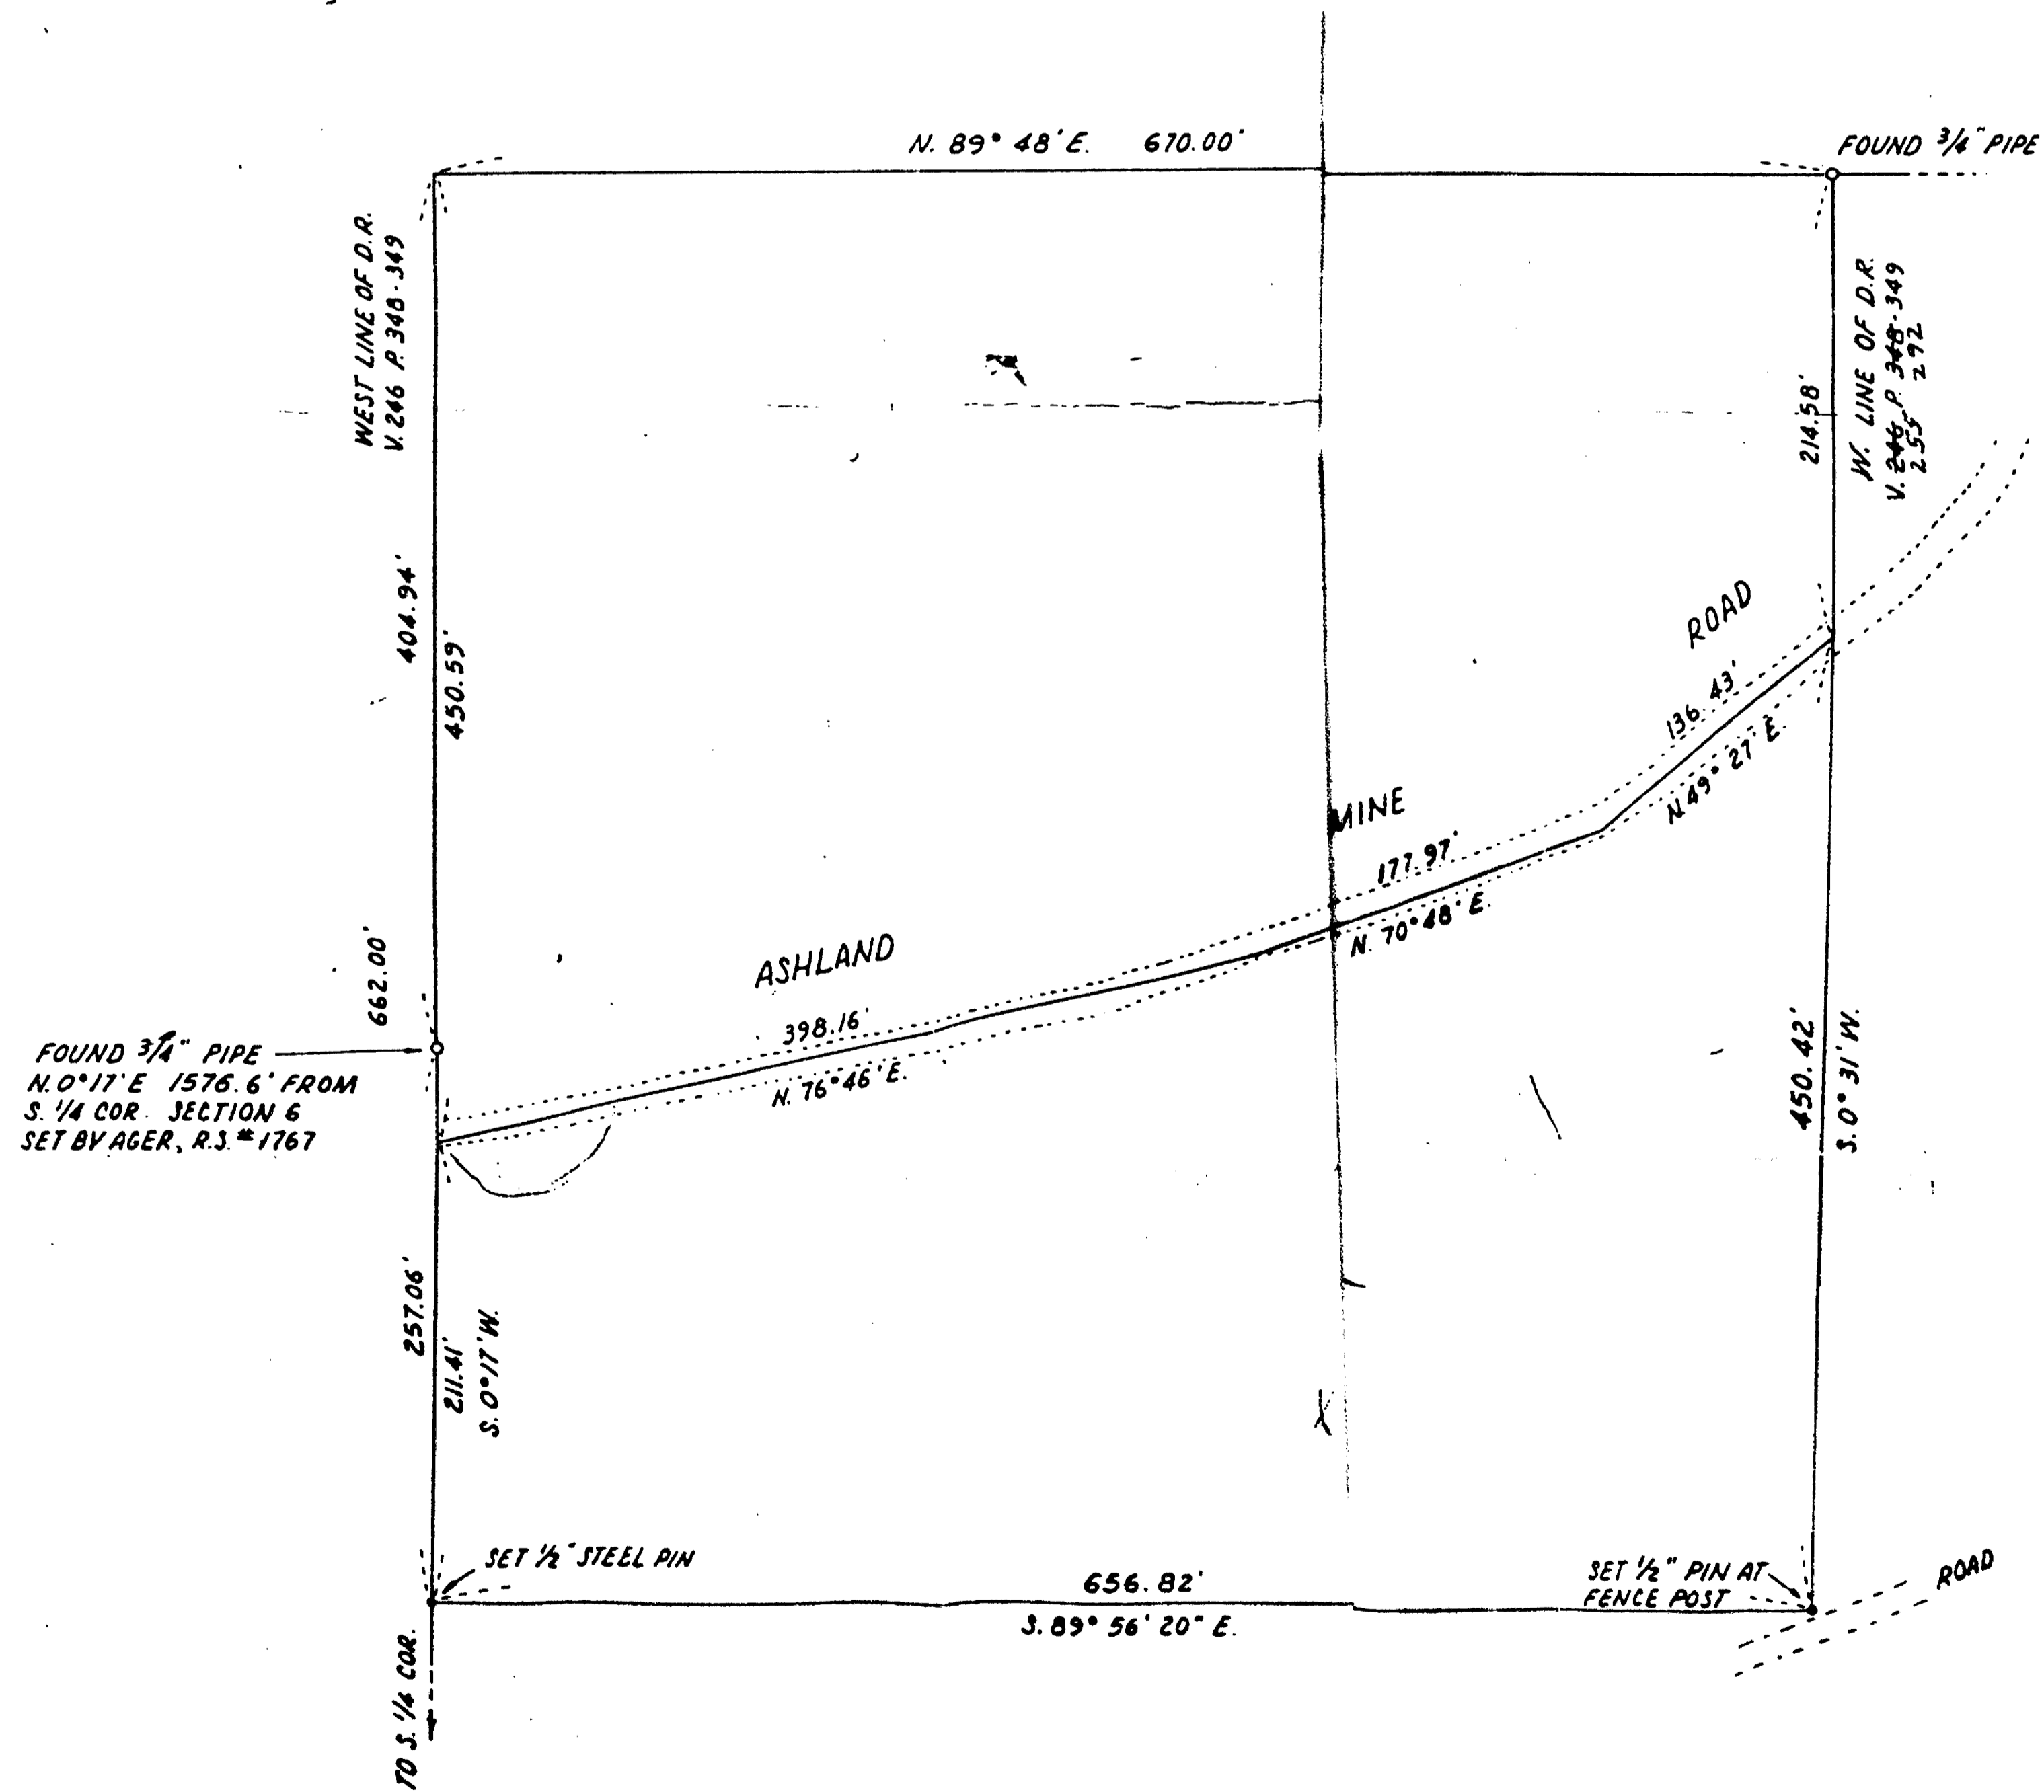

SURVEY MAP

SNIDER TO GOERTZEL

SEC. 6 T. 39S. R. 1E.  
 JACKSON COUNTY, OREGON  
 SCALE 1"=100' HUGH C. INGLE  
 OCT. 1970 CIVIL ENGINEER

Roll 541 245 5118

HUGH C. INGLE  
 CIVIL ENGINEER

17090