17179

SURVEY FOR:
Theron and Elizabeth Jule
29190 Highway 62
Trail, OR. 97541

LOCATION:
N.W. 1/4 of Section 32,
T.33S.,R.1E., W.M.,
Jackson County, Oregon

SURVEY BY:
Kaiser Surveying
19440 Highway 62
Eagle Point, OR. 97524

DATE:
January 14, 2002

LEGEND

△ = Found 5/8" Rebar with Plastic Cap – S.N. 9954

○ = Found Monument as Indicated

● = Set 5/8" x 24" Rebar with Plastic Cap marked "KAISER RLS 803"

S.N. = Filed Survey Number County Surveyors Office

W.C. = Witness Corner

( ) = Record S.N.'s 6839, 9954, 15010 and Parcel No. 2 of Inst. No. 01–46631 O.R.

(( )) = Record Vol. 269, Page 227 D.R., Vol. 283, Page 255 D.R., Inst. No. 76–08166 O.R. and Parcel No. 1 of Inst. No. 01–46631 O.R.

REGISTERED
PROFESSIONAL
LAND SURVEYOR
G.D.K.
OREGON
JULY 16, 1967
GARY D. KAISER
No. 803
EXP. 6-30-03

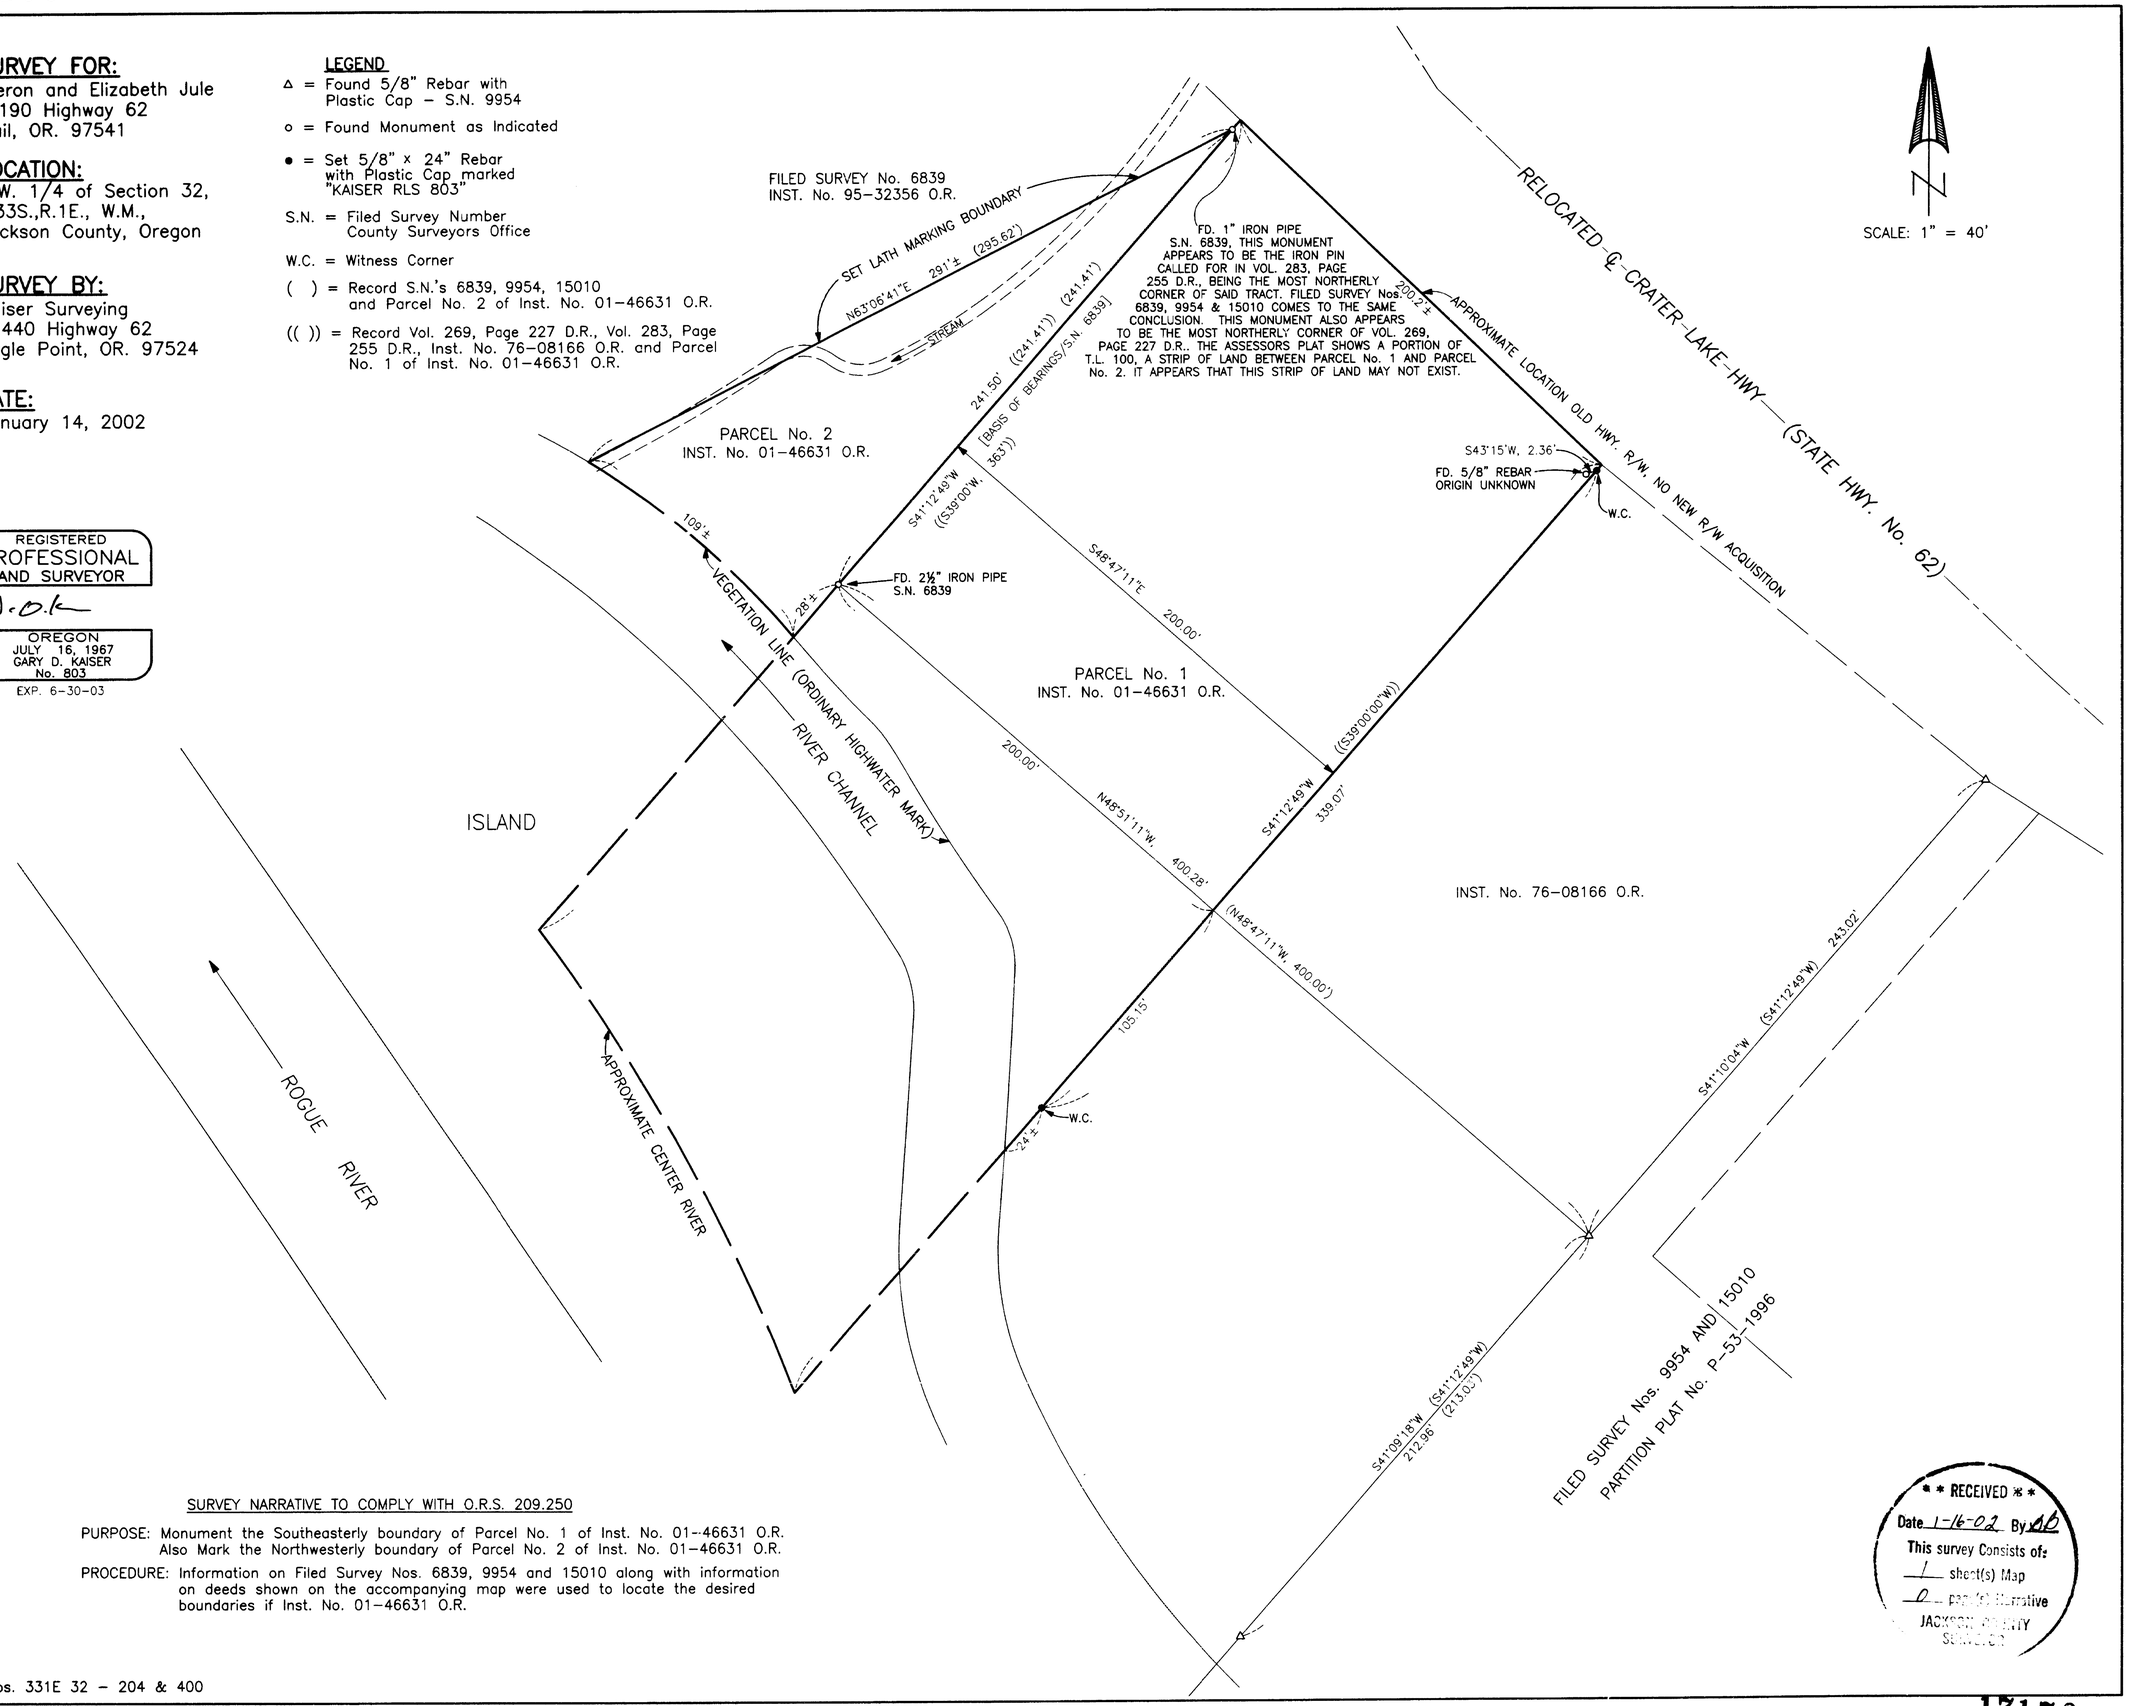

SURVEY NARRATIVE TO COMPLY WITH O.R.S. 209.250

PURPOSE: Monument the Southeasterly boundary of Parcel No. 1 of Inst. No. 01--46631 O.R. Also Mark the Northwesterly boundary of Parcel No. 2 of Inst. No. 01–46631 O.R.

PROCEDURE: Information on Filed Survey Nos. 6839, 9954 and 15010 along with information on deeds shown on the accompanying map were used to locate the desired boundaries if Inst. No. 01–46631 O.R.

** RECEIVED **
Date 1-16-02 By DD
This survey Consists of:
1 sheet(s) Map
0 page(s) Narrative
JACKSON COUNTY SURVEYOR

T.L. Nos. 331E 32 – 204 & 400

17179