

MAP OF SURVEY
 FOR
 I.S. THOMAS SOUTH PIONEER ROAD
 MEDFORD, OREGON
 IND. L.C. #51, SEC. 18, T. 38 S. R. 1 W. W.M.
 JACKSON COUNTY, OREGON
 DATE: 5-23-61 SCALE: 1/2"=100'
 SOLAR BEARINGS

REGISTERED
 OREGON
 LAND SURVEYOR
 L. E. AGER
 MARCH 10, 1944
 L. E. AGER
 21

REGISTERED
 JUN 18 1961
 COUNTY OF JACKSON

SEC. 13,
 T. 38 S. R. 2 W.

SEC. 18, T. 38 S. R. 1 W.

1/4 COR. 3/4" IRON PIPE & 2 OAK STUMPS ORIG. B.T.S.

Survey narrative to comply with ORS 209.250, Oregon State Law of 1947

For: I. S. Thomas, Rt. 4, Box 428 A, Medford, Oregon.



Purpose: To mark the boundaries of tracts 1, 2 and 3 shown on the map, also to show the T. I. D. Canal in relationship to these tracts and the location of the Canal thru portion of the Thomas property, also a road along the Canal extending from tract 3 to the Pioneer Road.

Procedure: For parcel # 1, began at the west $\frac{1}{4}$ corner of Section 18 and traversed to a point on the southerly line of the Pioneer Road at the distances north and east of the $\frac{1}{4}$ corner by coordinates and surveyed the boundaries as shown on the map.

Parcels 2 and 3, began at old points at the southeast corner of the tract 2 and along the easterly line which are marked with iron pipes and iron rods and surveyed the boundaries thereof, tying to the center-line points of the T.I.D. Canal which center-line was marked with hubs and tacks.

The Canal is platted on the map according to the field note data of the center-line bearings, distances & curvature.

The road was set from the existing ditch survey by offsets.

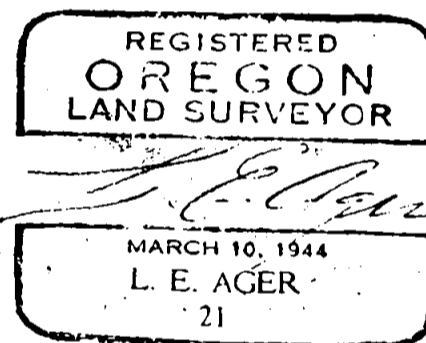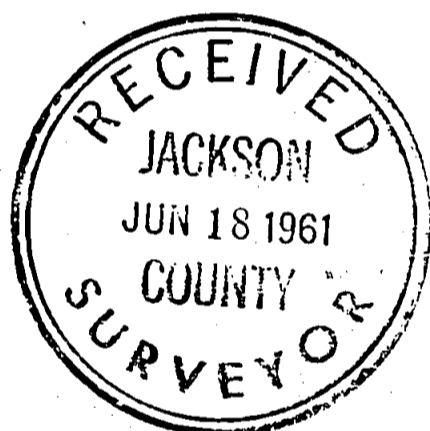

MAP OF SURVEY
 FOR
 I.S. THOMAS SOUTH PIONEER ROAD
 MEDFORD, OREGON
 IN D.L.C. #51, SEC. 18, T.38S. R.1W. W.M.
 JACKSON COUNTY, OREGON
 DATE: 5-23-61 SCALE: 1"=100'
 SOLAR BEARINGS

REGISTERED
 OREGON
 LAND SURVEYOR
 L. E. ACER
 MARCH 10, 1944
 21

RECEIVED
 JACKSON
 COUNTY
 SURVEYOR
 JUN 18 1961

