17202

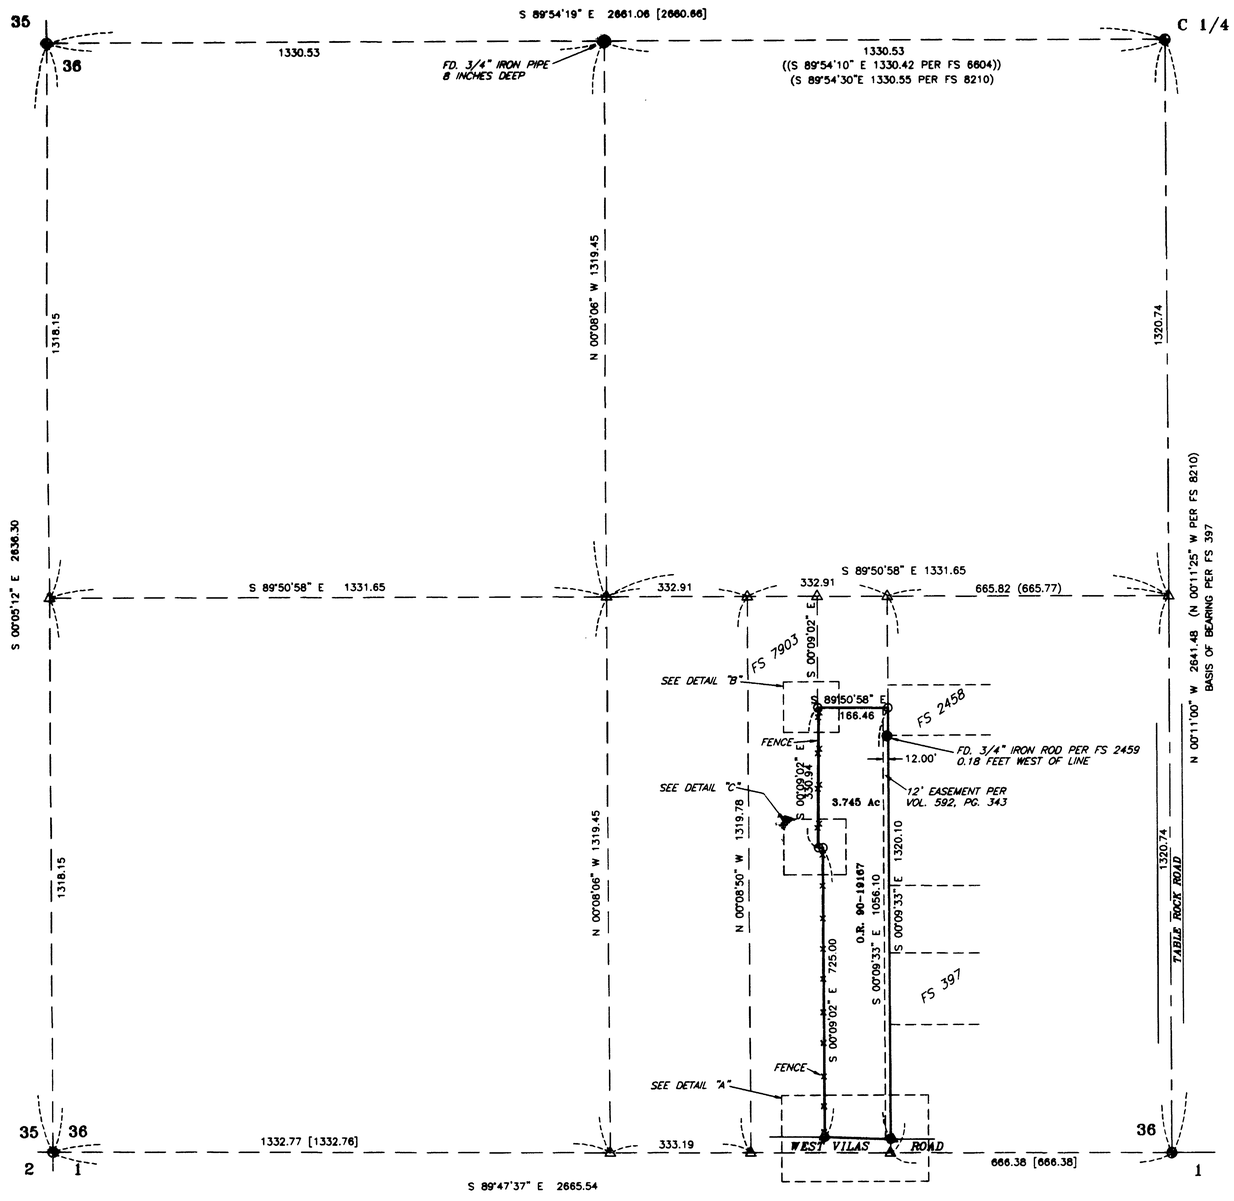

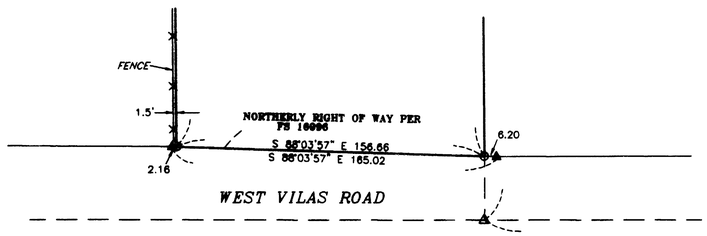

DETAIL "A"

** RECEIVED **
Date 2-3-02 By
This survey Consists of:
1 sheet(s) Map
0 page(s) Narrative

1 " = 200 '

LEGEND

- ○ SET 5/8" X 30" REBAR WITH PLASTIC CAP MARKED "TEMPLIN LS2359"
- ● FD. 5/8" IRON ROD PER FS UNLESS OTHERWISE NOTED
- ◓ INDICATES BRASS CAP MONUMENT PER JACKSON COUNTY RE-ESTAB.
- ▲ FD. 5/8" IRON ROD PER FS 16996
- △ INDICATES CALCULATED POSITION
- [ ] INDICATES RECORD DATA PER FILED SURVEY NUMBER 397
- ( ) INDICATES RECORD DATA PER FILED SURVEY NUMBER 2459 UNLESS OTHERWISE NOTED
- FS INDICATES FILED SURVEY

BASIS OF BEARING: PER FS 397

SURVEY NARRATIVE

PURPOSE: To survey and mark the corners of Instrument number 90-19167 of the Official Records of Jackson County, Oregon.

PROCEDURE: I made ties to the N 1/4, C 1/4, S 1/4, SW corner of Section 36, CW 1/16 corner and found monuments set on filed survey 2459, 7903 and 16996. I searched for the CS 1/16 corner reported on filed survey number 2459, but could not find it. Monuments set on filed survey 397, along the Easterly line of said O.R. 90-19167, appear to have been destroyed by road construction. I computed the deed corner positions and set monuments as shown hereon. Existing fence were tied in and shown as depicted.

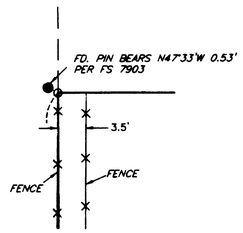

DETAIL "B"

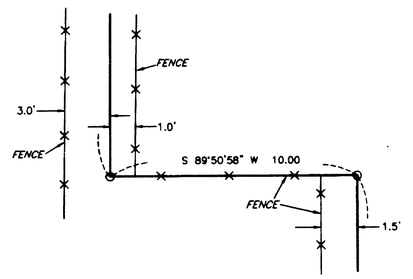

DETAIL "C"

FILE: "BCOFFICE.DWG"

REGISTERED PROFESSIONAL LAND SURVEYOR
OREGON JULY 28, 1986 RICHARD G. TEMPLIN 2359
MY CERTIFICATE EXPIRES JUNE 30, 2002

RICHARD TEMPLIN LAND SURVEYING
P.O. BOX 1946 899-2032 JACKSONVILLE, OREGON

MAP OF SURVEY

LOCATED IN
SE 1/4 OF THE SW 1/4 OF SECTION 36 ,T.36S., R.2W., W.M.
JACKSON COUNTY, OREGON

SURVEYED FOR: BCVSA
3915 S. Pacific Hwy.
Medford, Or. 97501

DATE: January 6, 2002

362W36C TL1000

17202