

1726

S89°51'10" E

AVENUE E

FD. 705.48'

1/2" I.PIN

1060.38'

3/4" I.PIN

709.64'

FD.

18.42 A.

30.42 A.

20.48 A.

1073.97'

S 0°12' W

X

IX

VIII

1251.30'

N 0°07'50" W

II

III

IV

SUB - D

AGATE



1726

455.84'

175.04'

1249.66'

S 0°11' W

S89°48' E

1060.00'

716.86'

FD.

FD.

AGATE

EXT - 3

SURVEY IN SEC. 22 T. 36S., R. 1W., W.M.

FOR

BUD HOOVER

57-13-10


BY EDWARD A. MCGINTY

MEDFORD, OREGON

JUNE 1961

SCALE: 1"=300'

• = 5/8" I.PIN

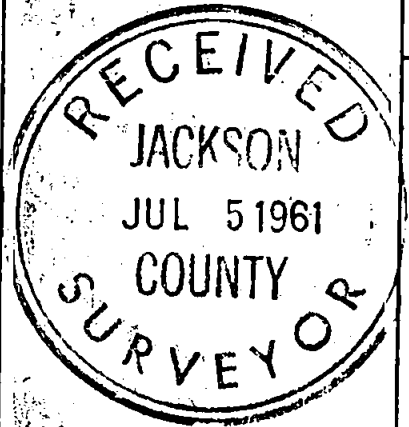

(17)

(18)

REGISTERED OREGON LAND SURVEYOR

Edward A. McGinty
JULY 16, 1961
EDWARD A. MCGINTY
301

ANTELOPE ROAD

1726

1726

Survey No. _____

Survey Narrative to comply with O.R.S. 209-120 and O.R.S. 209-205.

Survey for: Bud Hoover

Survey by: Edward A. McGinty, L.S.
6/17/61

BASIS OF BEARING: Agate Sub-division Ext. No. 3.


PRECEDENCE OF SURVEY:

Surveyed a 30.42 acres tract.

the southerly line was determined from lot pins found along the northerly line of Agate Sub-division Ext. No. 3 as shown.

The northerly line was determined from iron pins along the southerly line of Ave. E.

Surveyed tract as shown.

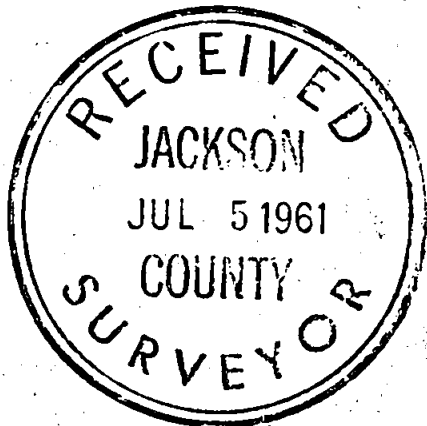

Edward A. McGinty

