

*** RECEIVED ***
 Date 4-15-02 By AB
 This survey Consists of:
 / sheet(s) Map
 / parcel Narrative
 JACKSON COUNTY
 CLERK



SCALE 1" = 50'

Basis of bearings R.S. No. 2984

LEGEND

- = Set 5/8"x24" Iron Pin (tagged PLS 638)
- = Found 5/8" i. Pin per R.S. No. 2984
(unless noted otherwise)
- OR.J.C.O. = Official Records Jackson County OR
- A = Fd. 5/8" i. Pin S. 0.06 and W. 2.67 from position shown
- Rec. = Record of R.S. No. 2984 and Dec. No. 66-04579 O.R.J.C.O.
- x-x- = Existing wire fence

Examined and approved by the Jackson County
 Department of Planning and Development

By: Michael Savage Date: 4-1-99
 (File No. 98-402-PA)

MAP OF SURVEY
 OF

Property Line Adjustment located in the N.W.
 1/4 of Section 27, Township 36 South, R3W W.M.
 For: STEVEN CARDINAL
 By: George Burrell, PLS., 1379 Brookdale Ave.
 Medford, Oregon 97504, Mar. 15, 1999

REGISTERED
PROFESSIONAL
LAND SURVEYOR
George Burrell
 OREGON
 JULY 10, 1984
 GEORGE R. BURRELL
 638

Exp. 12/31/99

SURVEY NARRATIVE TO COMPLY WITH O.R.S. 209.250

For:

Steven Cardinal
6671 Cypress Drive
Central Point, OR 97502

Location:

The Northwest ¼ of Section 27, Township 36 South, Range 3 West of the Willamette Meridian.

Purpose:

To monument and describe a property line adjustment between tax lots no. 1938 and 1947 -36-3W-27

Procedure:

The controlling monuments, originally established by recorded survey no. 2984 for the centerline of Cypress Drive, Carolina Drive and the exterior boundaries of said tax lots were traversed to holding the centerline of Cypress Drive as the basis of bearings. The new division boundary between said tax lots was then established and monumented according to the client's instructions and County Planning approval. Descriptions for the adjusted tax lots were furnished the client for recording the property line adjustment deeds.


NOTE: This map of survey was recently discovered by me, it inadvertently became misplaced in my files while awaiting the property line adjustment deed recording numbers as required by County Planning, which was not forthcoming from my client. The deed recording numbers were recently obtained from the County Assessor's Office.

By:

George Burrell, PLS
2305-C Ashland Street #261
Ashland, Oregon 97520
April 10,2002



George Burrell

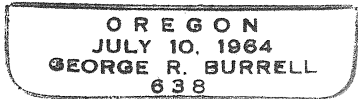

Exp.12/31/03

