

CHAUTAUQUA TRACE, PHASE 2



KEY MAP TO POST MONUMENTATION

PREPARED BY:

L.J. FRIAR & ASSOCIATES, P.C.
CONSULTING LAND SURVEYORS
816 WEST 8TH STREET
MEDFORD, OR 97501
PH: 772-2782

○ = SET BRASS TAG MKD. LS2234 IN LEAD PLUG IN CONCRETE.

⊗ = SET BRASS TAG MKD. L.J. FRIAR & ASSOC IN LEAD PLUG IN CONCRETE.

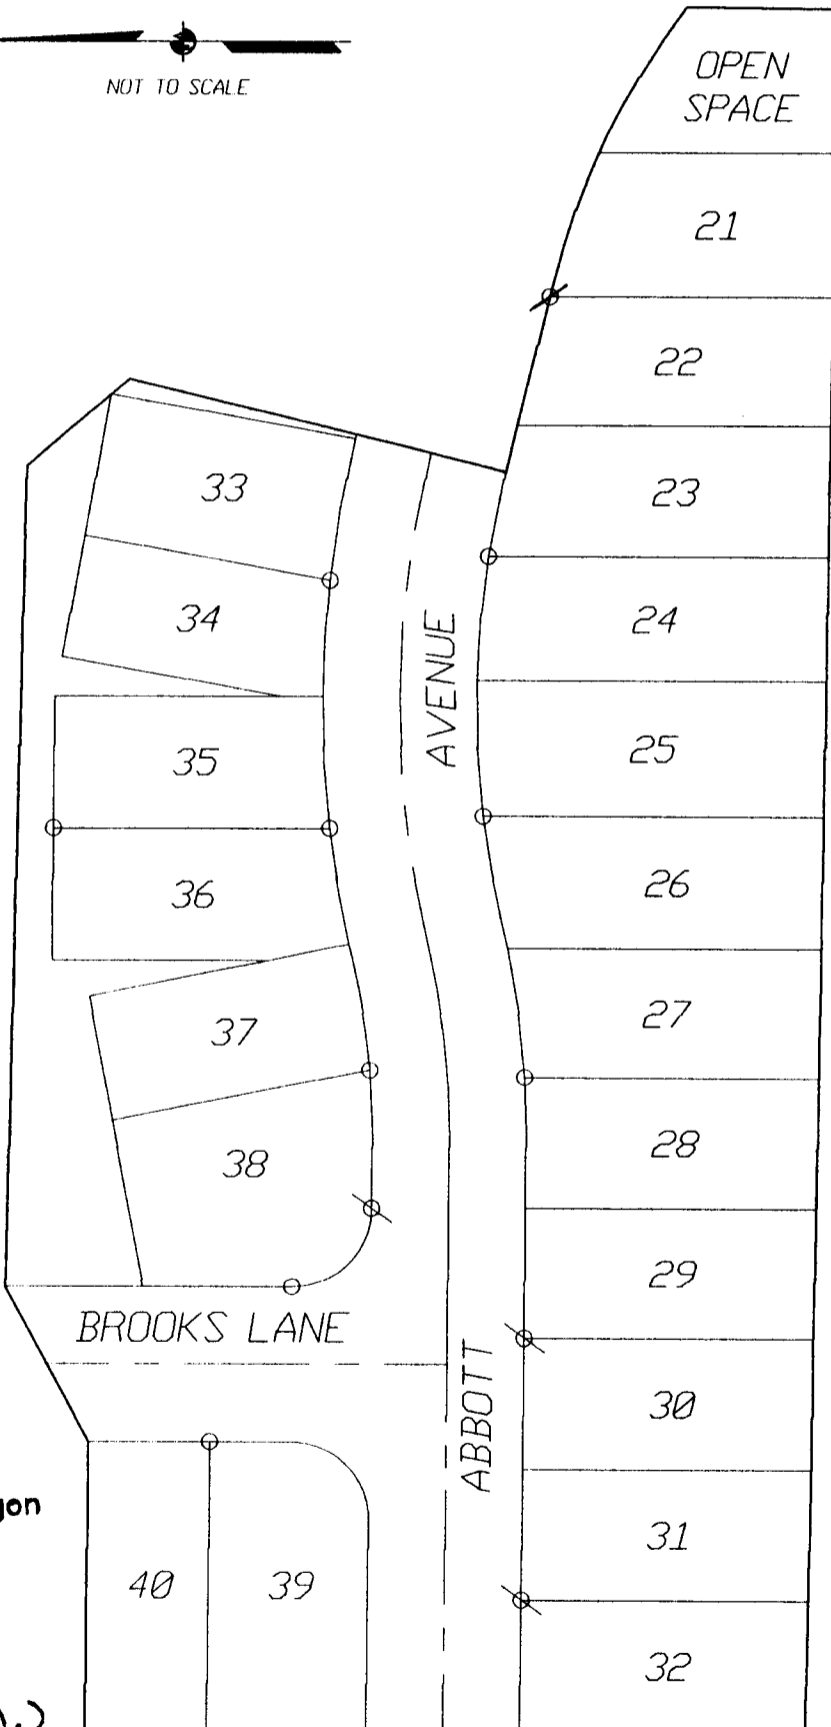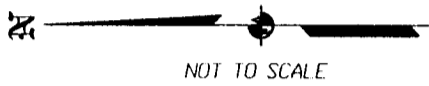

Jackson County, Oregon
Recorded
OFFICIAL RECORDS
MAY 02 2002
10:22 AM
Richard S. Beck
COUNTY CLERK

21