



# CHAUTAUQUA TRACE, PHASE 1

02 24496

KEY MAP TO POST MONUMENTATION

PREPARED BY:


L.J. FRIAR & ASSOCIATES, P.C.  
CONSULTING LAND SURVEYORS  
816 WEST 8TH STREET  
MELTON, OR 97501  
PH: 712-2782

○ = SET BRASS TAG MKD. LS2234 IN LEAD PLUG IN CONCRETE.

N



NOT TO SCALE

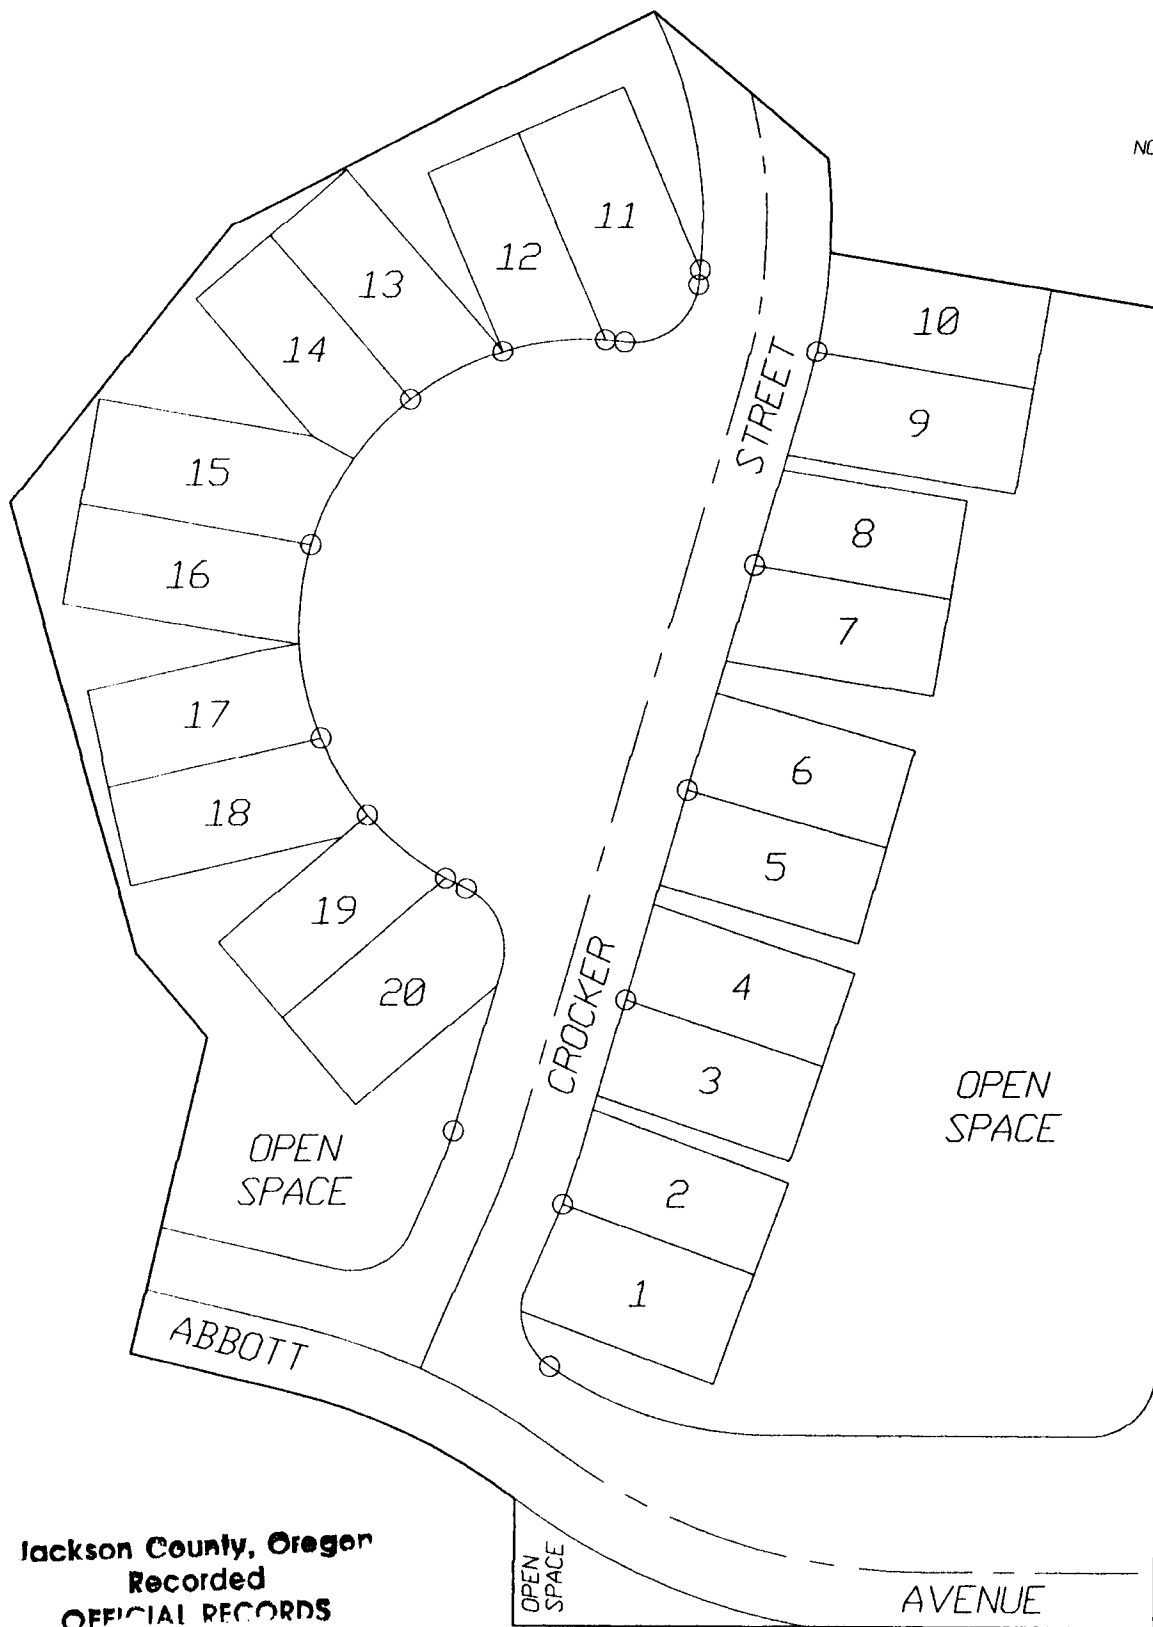

Jackson County, Oregon  
Recorded  
OFFICIAL RECORDS

MAY 02 2002

10:22 AM

*John S. Beckwith*  
COUNTY CLERK