



02 24497

# CHAUTAUQUA TRACE, PHASE 3

KEY MAP TO POST MONUMENTATION

17307


PREPARED BY:

L.J. FRIAR & ASSOCIATES, P.C.  
CONSULTING LAND SURVEYORS  
816 WEST 8TH STREET  
MEDFORD, OR 97501  
PH: 772-2782

○ = SET BRASS TAG MKD. LS2234 IN LEAD PLUG IN CONCRETE.



NOT TO SCALE

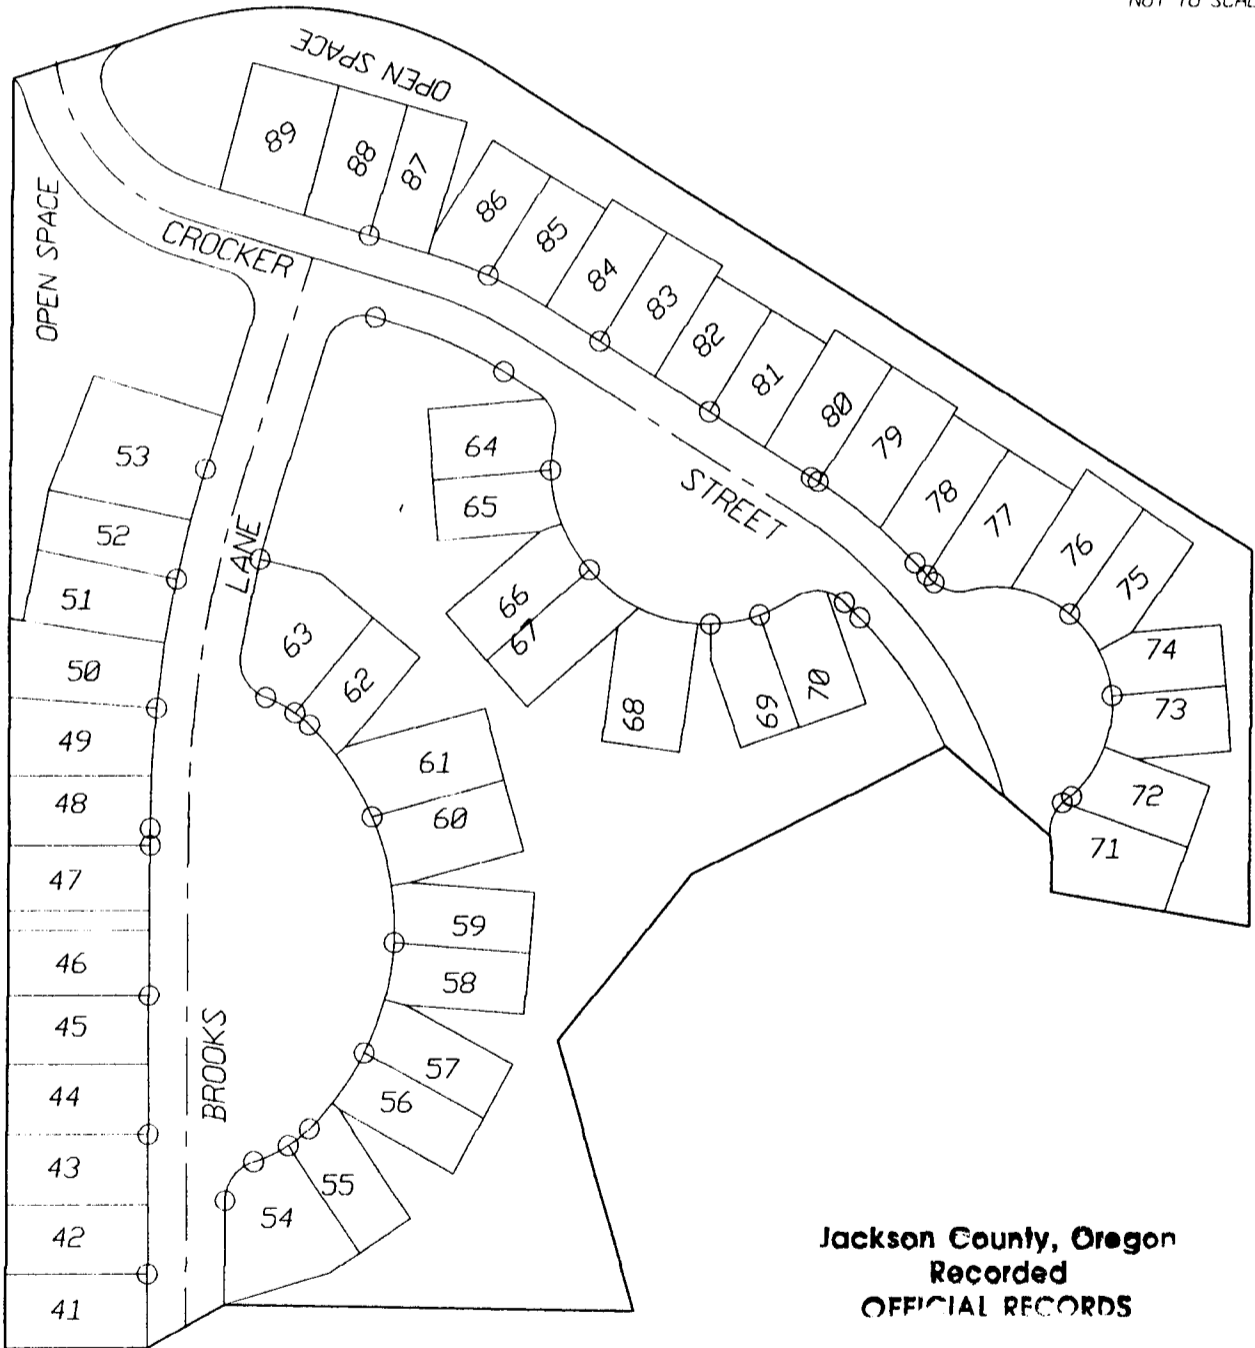

Jackson County, Oregon  
Recorded  
OFFICIAL RECORDS

MAY 02 2002

10:22 AM

*Frederick S. Beckwith*  
COUNTY CLERK