

Survey Narrative to Comply with Section 87-330

1947 Oregon State Laws

Survey For:

Mr. Paul K. Bender
P. O. Box 221
Shady Cove, Oregon
and
Mr. George Field
P. O. Box 347
Medford, Oregon

Purpose of Survey:

To establish property boundaries.

Survey Location:



Government Lots 2 and 9,
Section 3, Township 34 South,
Range 1 West, Willamette
Meridian, Jackson County,
Oregon.

Survey Procedure:

Found section and other corners,
as shown on map, and used as a
basis for survey control. Set
5/8" steel pins as shown.

Leland P. Lovejoy
Registered Land Surveyor

Work completed June 26, 1961

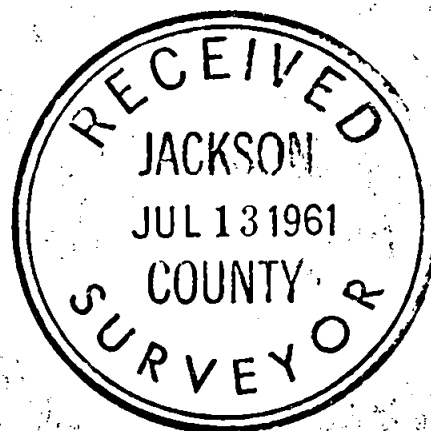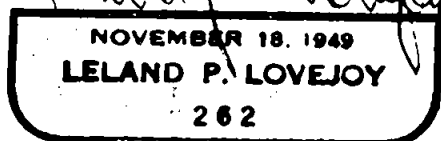

Survey Narrative to Comply with Section 87-3301947 Oregon State Laws

Survey For:

Mr. Paul K. Bender
 P. O. Box 221
 Shady Cove, Oregon
 and
 Mr. George Field
 P. O. Box 347
 Medford, Oregon

Purpose of Survey:

To establish property boundaries.

Survey Location:

Government Lots 2 and 9,
 Section 3, Township 34 South,
 Range 1 West, Willamette
 Meridian, Jackson County,
 Oregon.

Survey Procedure:

Found section and other corners,
 as shown on map, and used as a
 basis for survey control. Set
 5/8" steel pins as shown.

Leland P. Lovejoy
 Registered Land Surveyor

Work completed June 26, 1961

