

11330

MOUNTAIN CREEK ESTATES, A PLANNED COMMUNITY, PHASE 1

KEY MAP TO POST MONUMENTATION

PREPARED BY:

L.J. FRIAR & ASSOCIATES, P.C.
CONSULTING LAND SURVEYORS
816 WEST 8TH STREET
MEDFORD, OR 97501
PH 772-2782

⊗ = SET BRASS TAG MKD. LS2234 IN LEAD PLUG IN CONCRETE


**** RECEIVED ****
Date 5-14-02 By BB
This survey consists of:
1 plat
2 sheet(s) Map
1 page(s) Narrative
JACKSON COUNTY
SURVEYOR

Jackson County, Oregon
Recorded
OFFICIAL RECORDS

MAY 14 2002
1:28 PM
Shirley S. Beckwith
COUNTY CLERK



02 26725

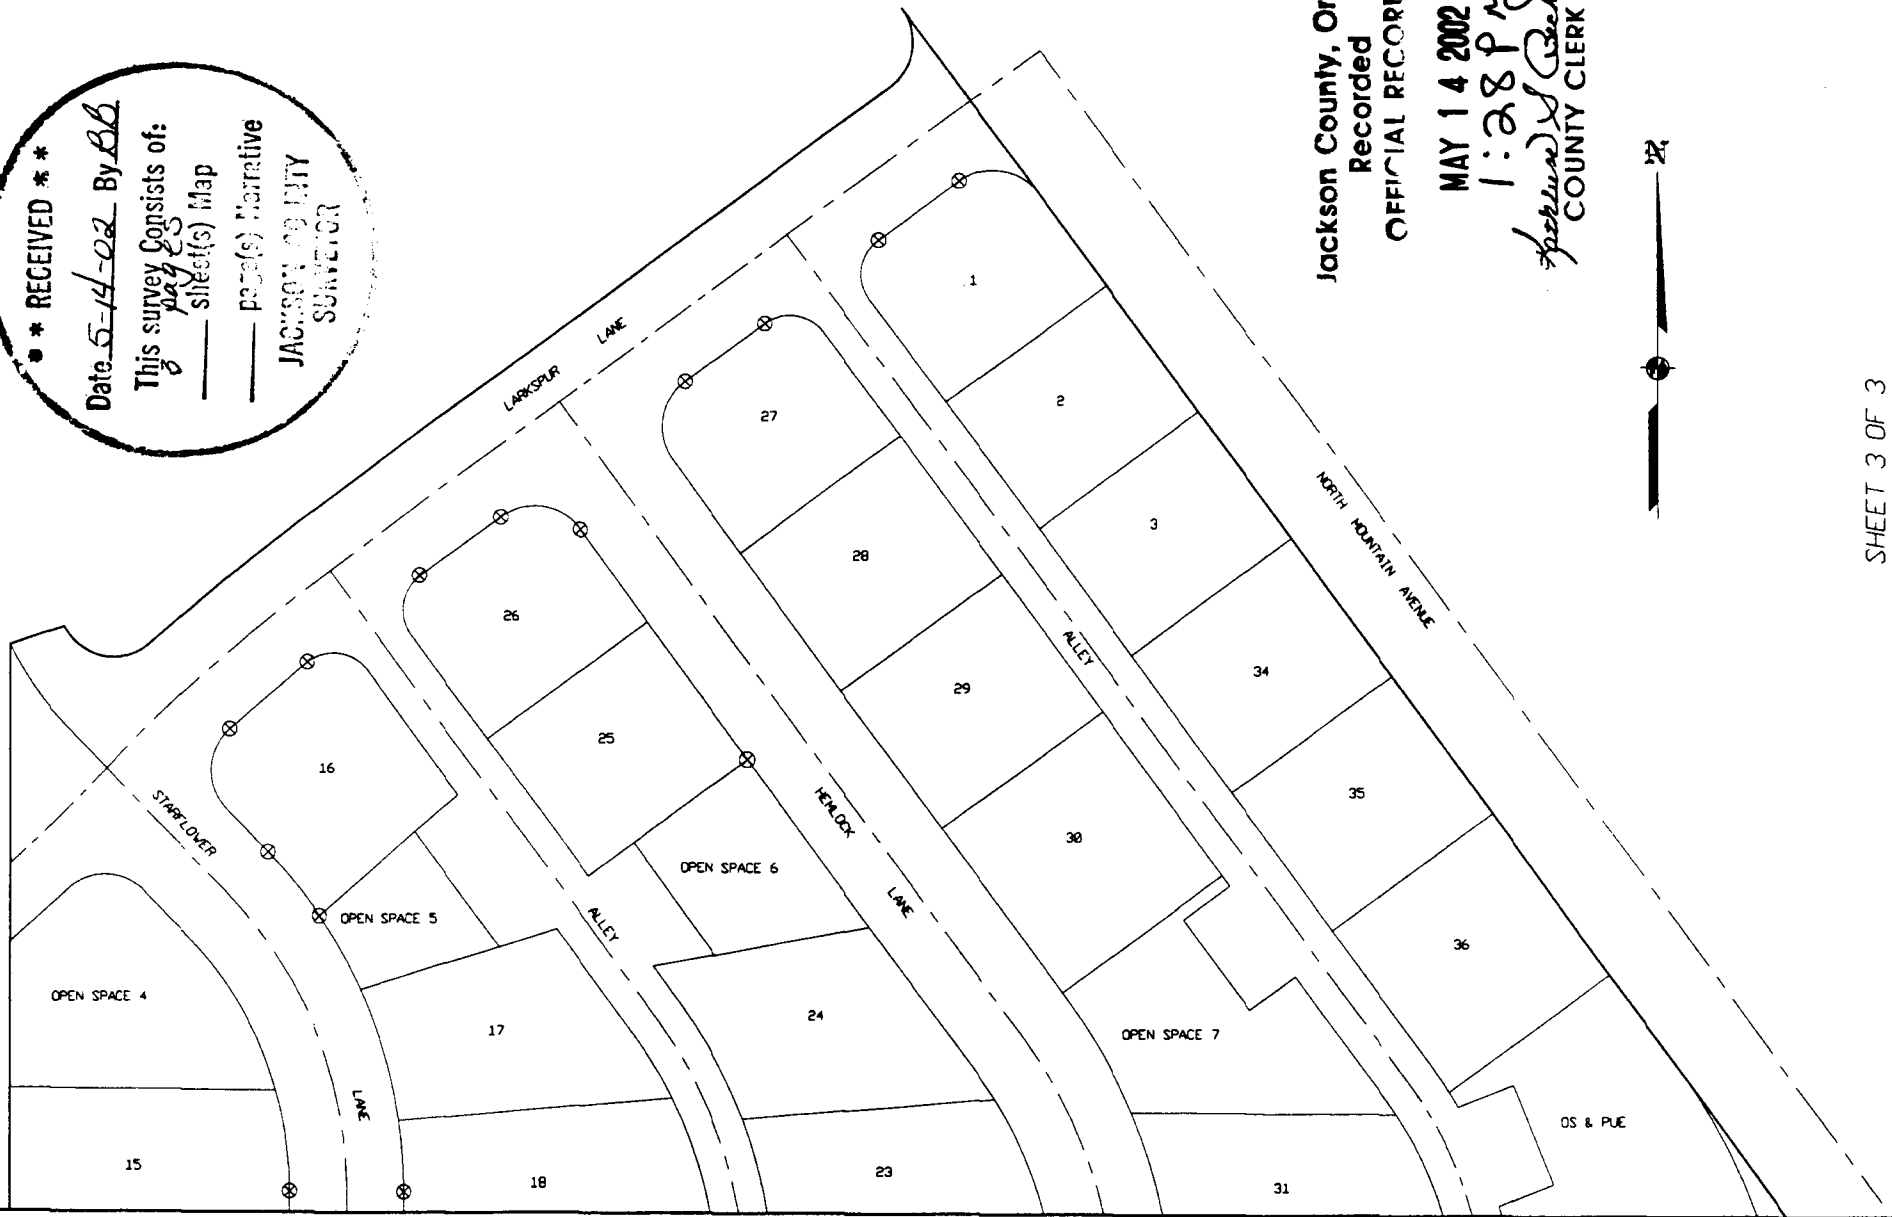

SHEET 3 OF 3

3

MOUNTAIN CREEK ESTATES, A PLANNED COMMUNITY, PHASE 1
 KEY MAP TO POST MONUMENTATION

PREPARED BY:

L.J. FRIAR & ASSOCIATES, P.C.
 CONSULTING LAND SURVEYORS
 816 WEST 8TH STREET
 MEDFORD, OR 97501
 PH. 772-2782

⊗ = SET BRASS TAG MKD. LS2234 IN LEAD PLUG IN CONCRETE.

● = SET 2.5" BRASS CAP MKD. L.J. FRIAR & ASSOC IN CONCRETE SIDEWALK.



02 26725

SHEET 2 OF 3

2