



PREPARED BY:


**WESTIN HEIGHTS SUBDIVISION**  
KEY MAP TO POST MONUMENTATION

L.J. FRIAR & ASSOCIATES, P.C.  
CONSULTING LAND SURVEYORS  
816 WEST 8TH STREET  
MEDFORD, OR 97501  
PH 772-2782

- ⊗ = SET BRASS TAG MKD. LS 2234 IN LEAD PLUG IN CONCRETE.
- = SET 5/8" REBAR W/YELLOW PLASTIC CAP MKD. "L.J. FRIAR & ASSOC." WITNESS MONUMENT, 1.00 FOOT FROM ACTUAL CORNER.
- ⊙ = SET 5/8" REBAR W/YELLOW PLASTIC CAP MKD. "L.J. FRIAR & ASSOC." WITNESS MONUMENT, 4.00 FEET FROM ACTUAL CORNER.

Jackson County, Oregon  
Recorded  
OFFICIAL RECORDS

JUN 19 2002  
2:16 PM  
*[Signature]*  
COUNTY CLERK

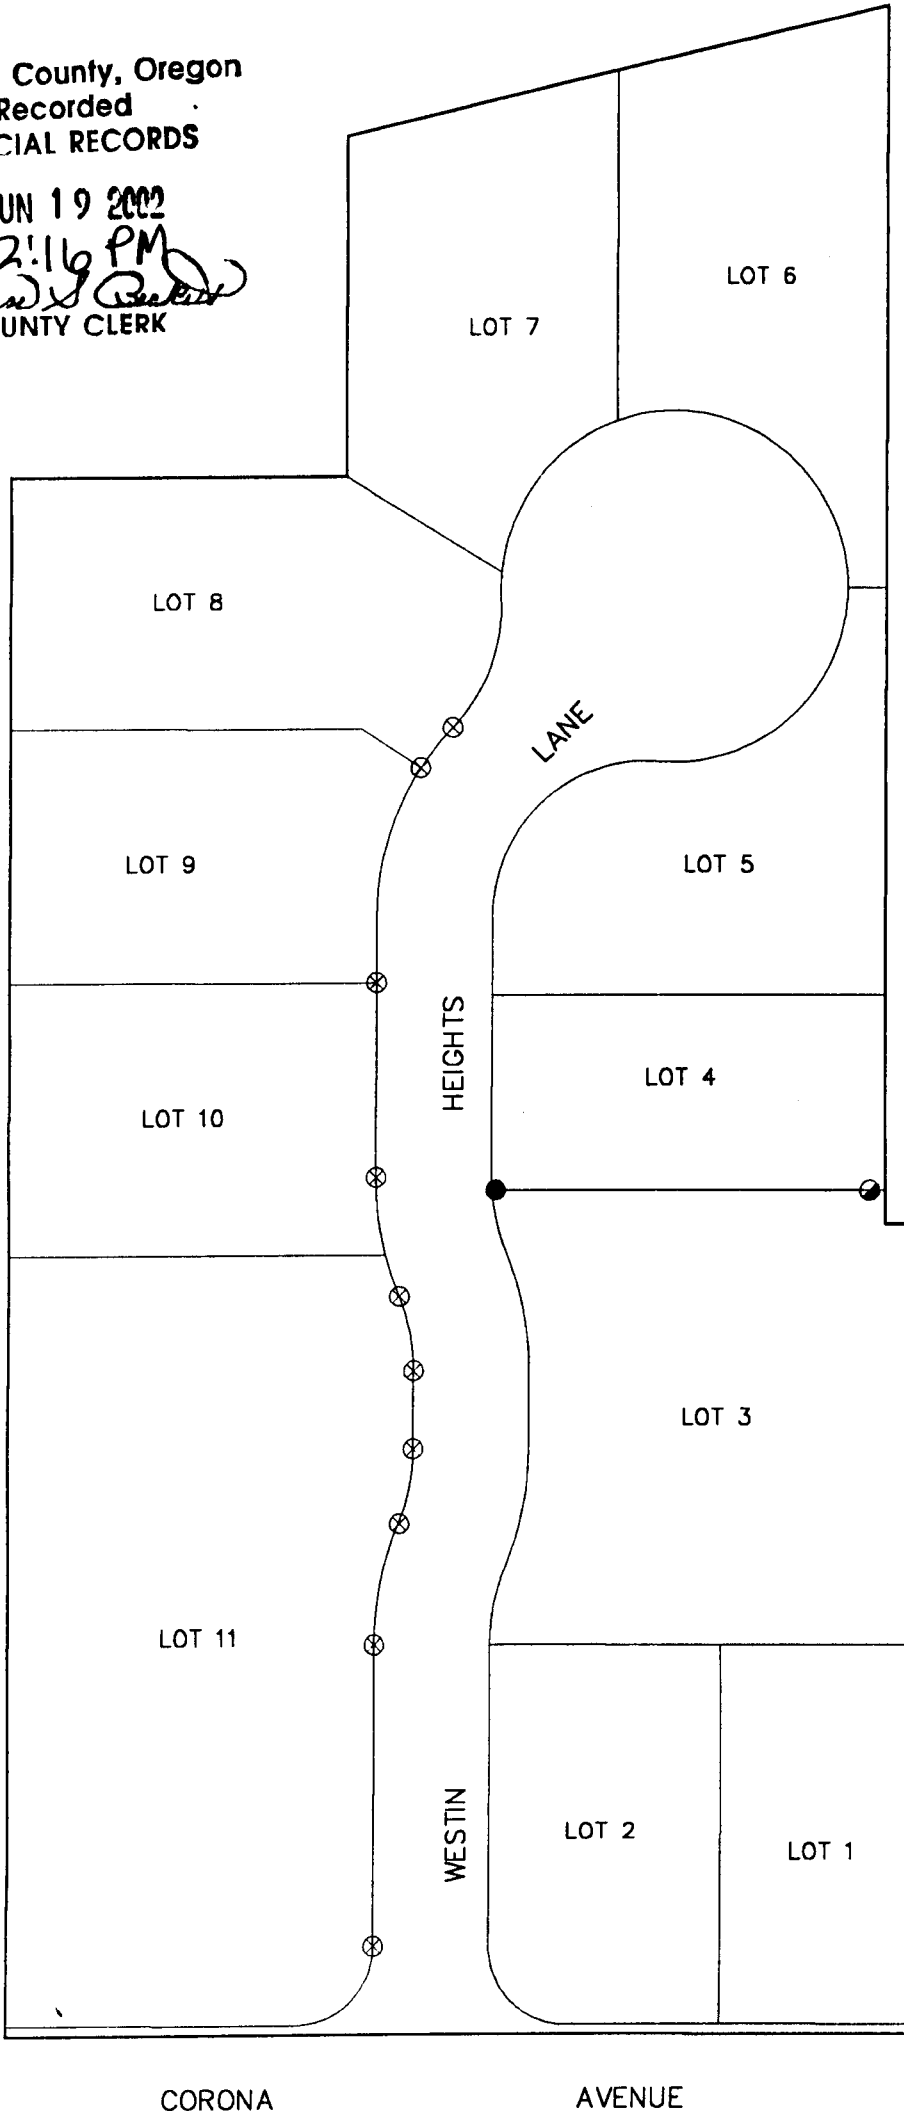

NOT TO SCALE