Property Line Adjustment

Approved by the City of Medford, Jackson County, Oregon
By: (NOT APPLICABLE) Date: _____

SURVEY FOR:
Southern Oregon Builders
2026 Lars Way
Medford, OR. 97501

SURVEY BY:
Kaiser Surveying
19440 Highway 62
Eagle Point, OR. 97524

LOCATION:
Lot 32 of SAGE ROAD INDUSTRIAL PARK – Unit No. 5 and Lot 44 of SAGE ROAD INDUSTRIAL PARK – Unit No. 6 and in the NE1/4 of Section 23, T.37S.,R.2W., W.M., City of Medford, Jackson County, Oregon

DATE:
May 15, 2002

SCALE: 1" = 50'

REGISTERED
PROFESSIONAL
LAND SURVEYOR
OREGON
JULY 16, 1967
GARY D. KAISER
No. 803
EXP. 6-30-03

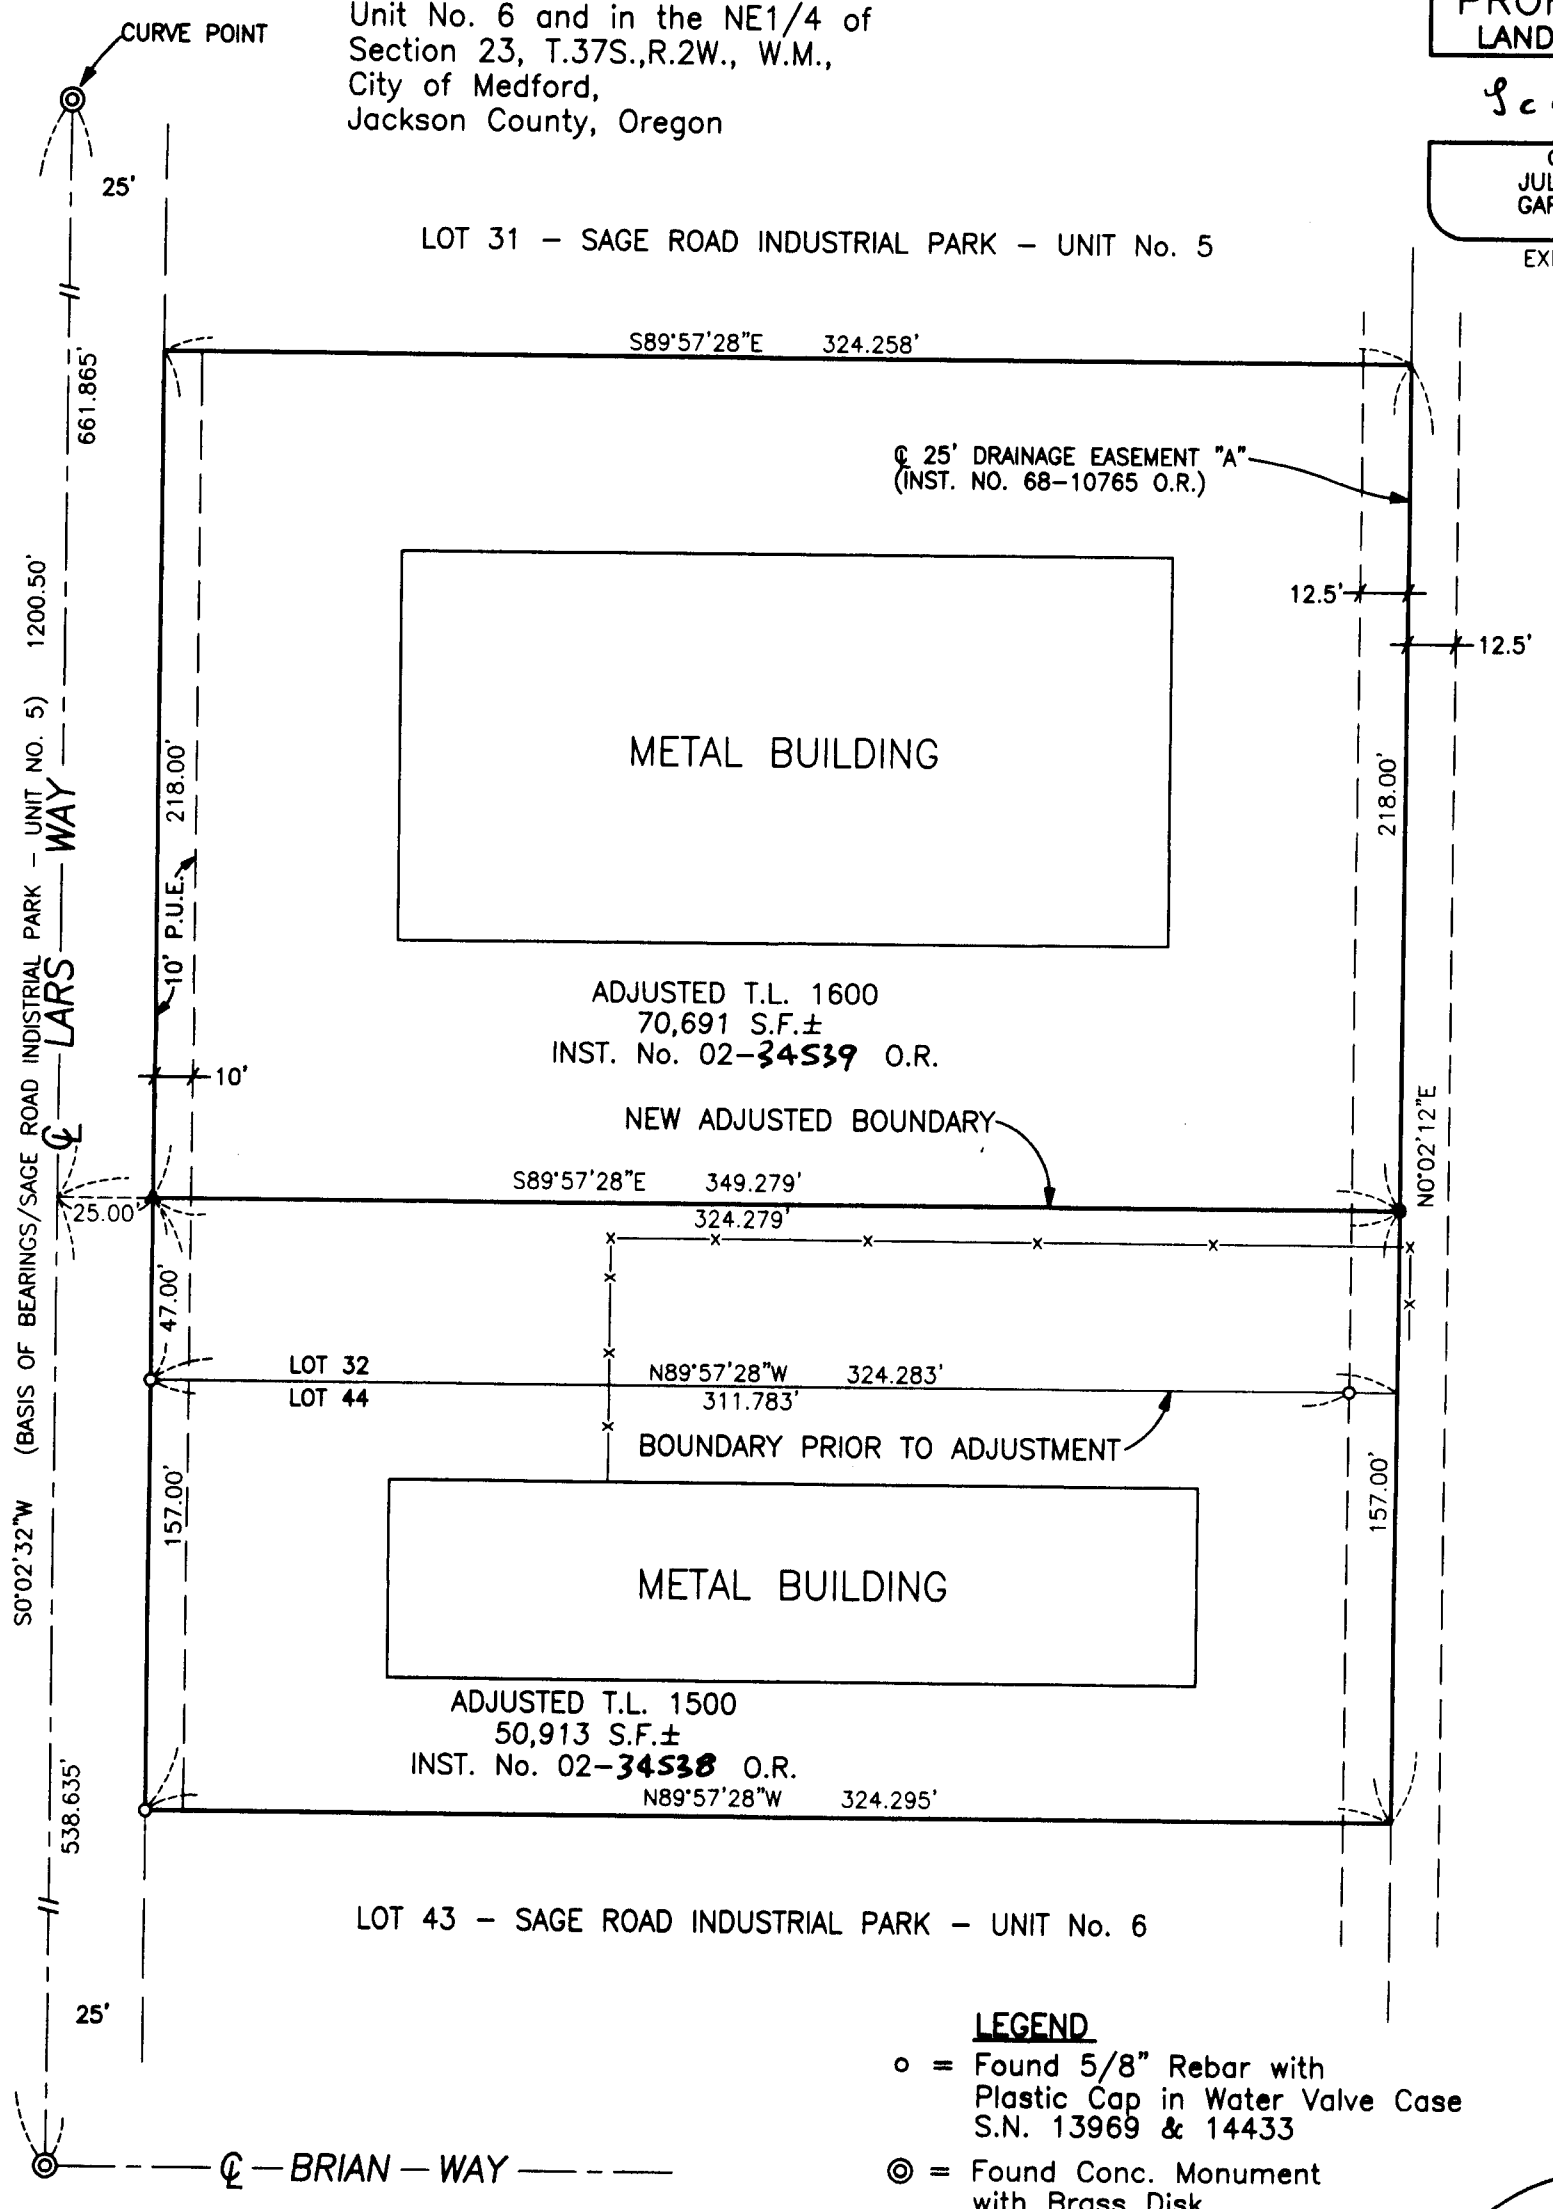

LEGEND

- o = Found 5/8" Rebar with Plastic Cap in Water Valve Case S.N. 13969 & 14433
- ◎ = Found Conc. Monument with Brass Disk
- ▲ = Set Lead/Tack/Washer Marked "RLS 803"
- ● = Set 5/8" x 24" Rebar with Aluminum Cap marked "KAISER RLS 803"
- S.N. = Filed Survey Number County Surveyors Office
- —x—x— = Fence

SURVEY NARRATIVE TO COMPLY WITH O.R.S. 209.250

PURPOSE: Property Line Adjustment Survey. Also prepare descriptions of the Adjusted Tax Lots.

PROCEDURE: Information on Plats of SAGE ROAD INDUSTRIAL PARK – Units 5 and 6 were used to locate the New Adjusted Boundary.

T.L. Nos. 372W 23A – 1500 & 1600

* * RECEIVED * *
Date 8-8-02 By
This survey consists of:
1 sheet(s) Map
0 page(s) Narrative
JACKSON COUNTY SURVEYOR