

1745

Survey No. _____

Mark E. Boyden, County Surveyor
Jackson County, Oregon
May 22, 1961

SUBJECT: Re-establishment of one sixteenth corner.

Township 34 South, Range 1 West, WM.


East 1/16 corner between Section 20 and 29.

Found a 1/2 inch iron pipe at corner from which,

Found a bearing tree, a black oak, 14 ins. diam., N.31 $\frac{1}{2}$ °E., 76.1 ft.

Found bearing stump, a black oak, 8 ins. diam., S.68 $\frac{1}{2}$ °W., 101.8 ft. dist.
instead of 101.1 ft. dist.

A black oak 8 ins. diam., bears S.64 $\frac{1}{4}$ °W., 85.5 ft. dist., makd. 301 BT.

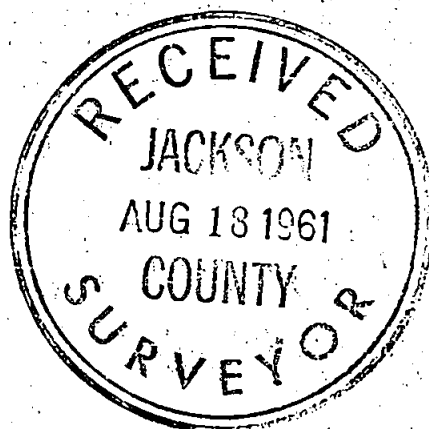

Edward A. McGinty

