

S.E. Cor. D.L.C. # 42
Fd. 1 1/2" iron pin

Set 5/8" iron pin

S 0° 06' 20" W
1759.31'

S.W. Cor. D.L.C. # 67
Fd. 7/8" iron pin

127.86'
N 56° 45' W

812.00'

N 57° 42' 20" W
HIGHWAY

JACKSONVILLE

18.86 Acres


1.15 AC

S 41° 21' 50" W 250.45'
S 57° 42' 20" E 234.68'

ROAD 1255.10'
N 41° 21' 50" E


HANLEY

Survey for:
ALICE VINCENT
Located in Sec. 28
T. 37S., R. 2 W., W.M.
By: Mark E. Boyden
August, 1961

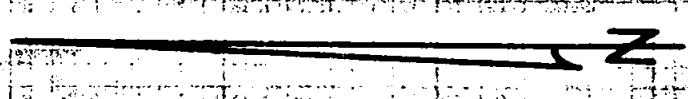

SCALE: 1" = 100'
o Fd. 5/8" iron pin
● Re-estab. Gov't. Cor.

REGISTERED
OREGON
LAND SURVEYOR
Mark E. Boyden
NOVEMBER 1, 1951
MARK E. BOYDEN

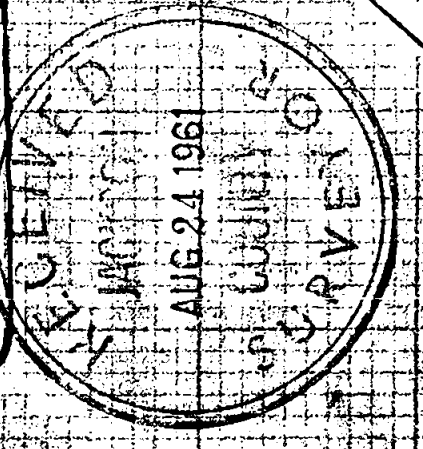

Survey No. 1749

SURVEY NARRATIVE TO COMPLY WITH O.R.S. 209.250

FOR: Alice Vincent
Jacksonville Highway
Medford, Oregon

PURPOSE: To monument and describe the Alice Vincent property described in Volume 127, Page 186 of the Deed Records of Jackson County, Oregon in two parcels.

LOCATION: SW $\frac{1}{4}$ of the NE $\frac{1}{4}$ of Section 28, T37SR2W.

PROCEDURE:

Previously recorded Survey No. 1737 established the monumented sidelines of the residence parcel.

This survey control was then extended to an intersection with the West boundary of DLC #67, setting a witness corner for the North property corner as shown, and then closed back to the SW corner of DLC #67.

Hanley Road line was changed slightly to conform with a line 30 feet Southeasterly from an existing fenceline near the Northwesterly boundary of Hanley Road. This line was then extended Southwesterly to an intersection with the Jacksonville Highway line used on said recorded Survey No. 1737.

A revised description of the residence parcel was then prepared and also a description of the remaining parcel, excepting from said parcels "that portion lying within the right-of-way of the Jacksonville Highway and Hanley County Roads."

August, 1961

