SURVEY NARRATIVE TO COMPLY WITH PARAGRAPH 209.250 OREGON REVISED STATUTES

FOR:

Denise Benson

1120 S. Mountain Ave. Ashland, Or. 97520

LOCATION: in the Northeast and the Southeast one-quarter's of Section 16, Township 39 South,

Range 1 East, Willamette Meridian, City of Ashland, Jackson County, Oregon.


PURPOSE: To survey and monument those tracts of land described in Instruments No. 71-02513

and 76-04005 of the official records of Jackson County, Oregon.

PROCEDURE: Utilizing a Leica TCA 1800 total station, a control traverse was run tying found monuments as shown and also tied into survey control previously established by this office for Pine View Estates Subdivision.

Client owns 2 tax lots, currently designated as Tax Lot 1400 and Tax Lot 1303 by the County Assessor's Office. In 1971 ownership of Tax Lot 1404 was conveyed to James & Denise Benson from Richard & Virginia Westerfield by warranty deed Instrument No. 71-02513. The point of beginning of the property conveyed is 166.5' west of the East 1/4 corner of Section 16. In 1976 another deed was filed for record, (Instrument No. 76-03760) titled a "Corrected Warranty Deed and Easements" whereby Richard and Virginia convey to James and Denise Benson. The point of beginning of the second deed is 167,5' feet West of the East 1/4 corner of Section 16. The revised point of beginning moves the East line of the Benson property 1.00 foot west, creating a 1.00 foot deed gap between the Benson property and the adjoining property to the east. I spoke to Mrs. Benson regarding the second deed and she was surprised that it existed. She could not remember ever having seen a second deed. According to Mrs. Benson the property was paid for, free and clear before 1976. Mrs. Benson contacted Mrs. Westerfield, who couldn't remember the particulars regarding the second deed, but she seemed to feel that a real estate person had been instrumental in having the deed corrected. The validity of the correction deed is questionable since the Benson's were, at the date of the correction deed, the fee owners of the property and were not a party to the new deed. I therefore held the original 1971 deed to control the location of Tax Lot 1400.

Now then, regarding the location of tax lot 1303 as described in Instrument No. 76-04005.

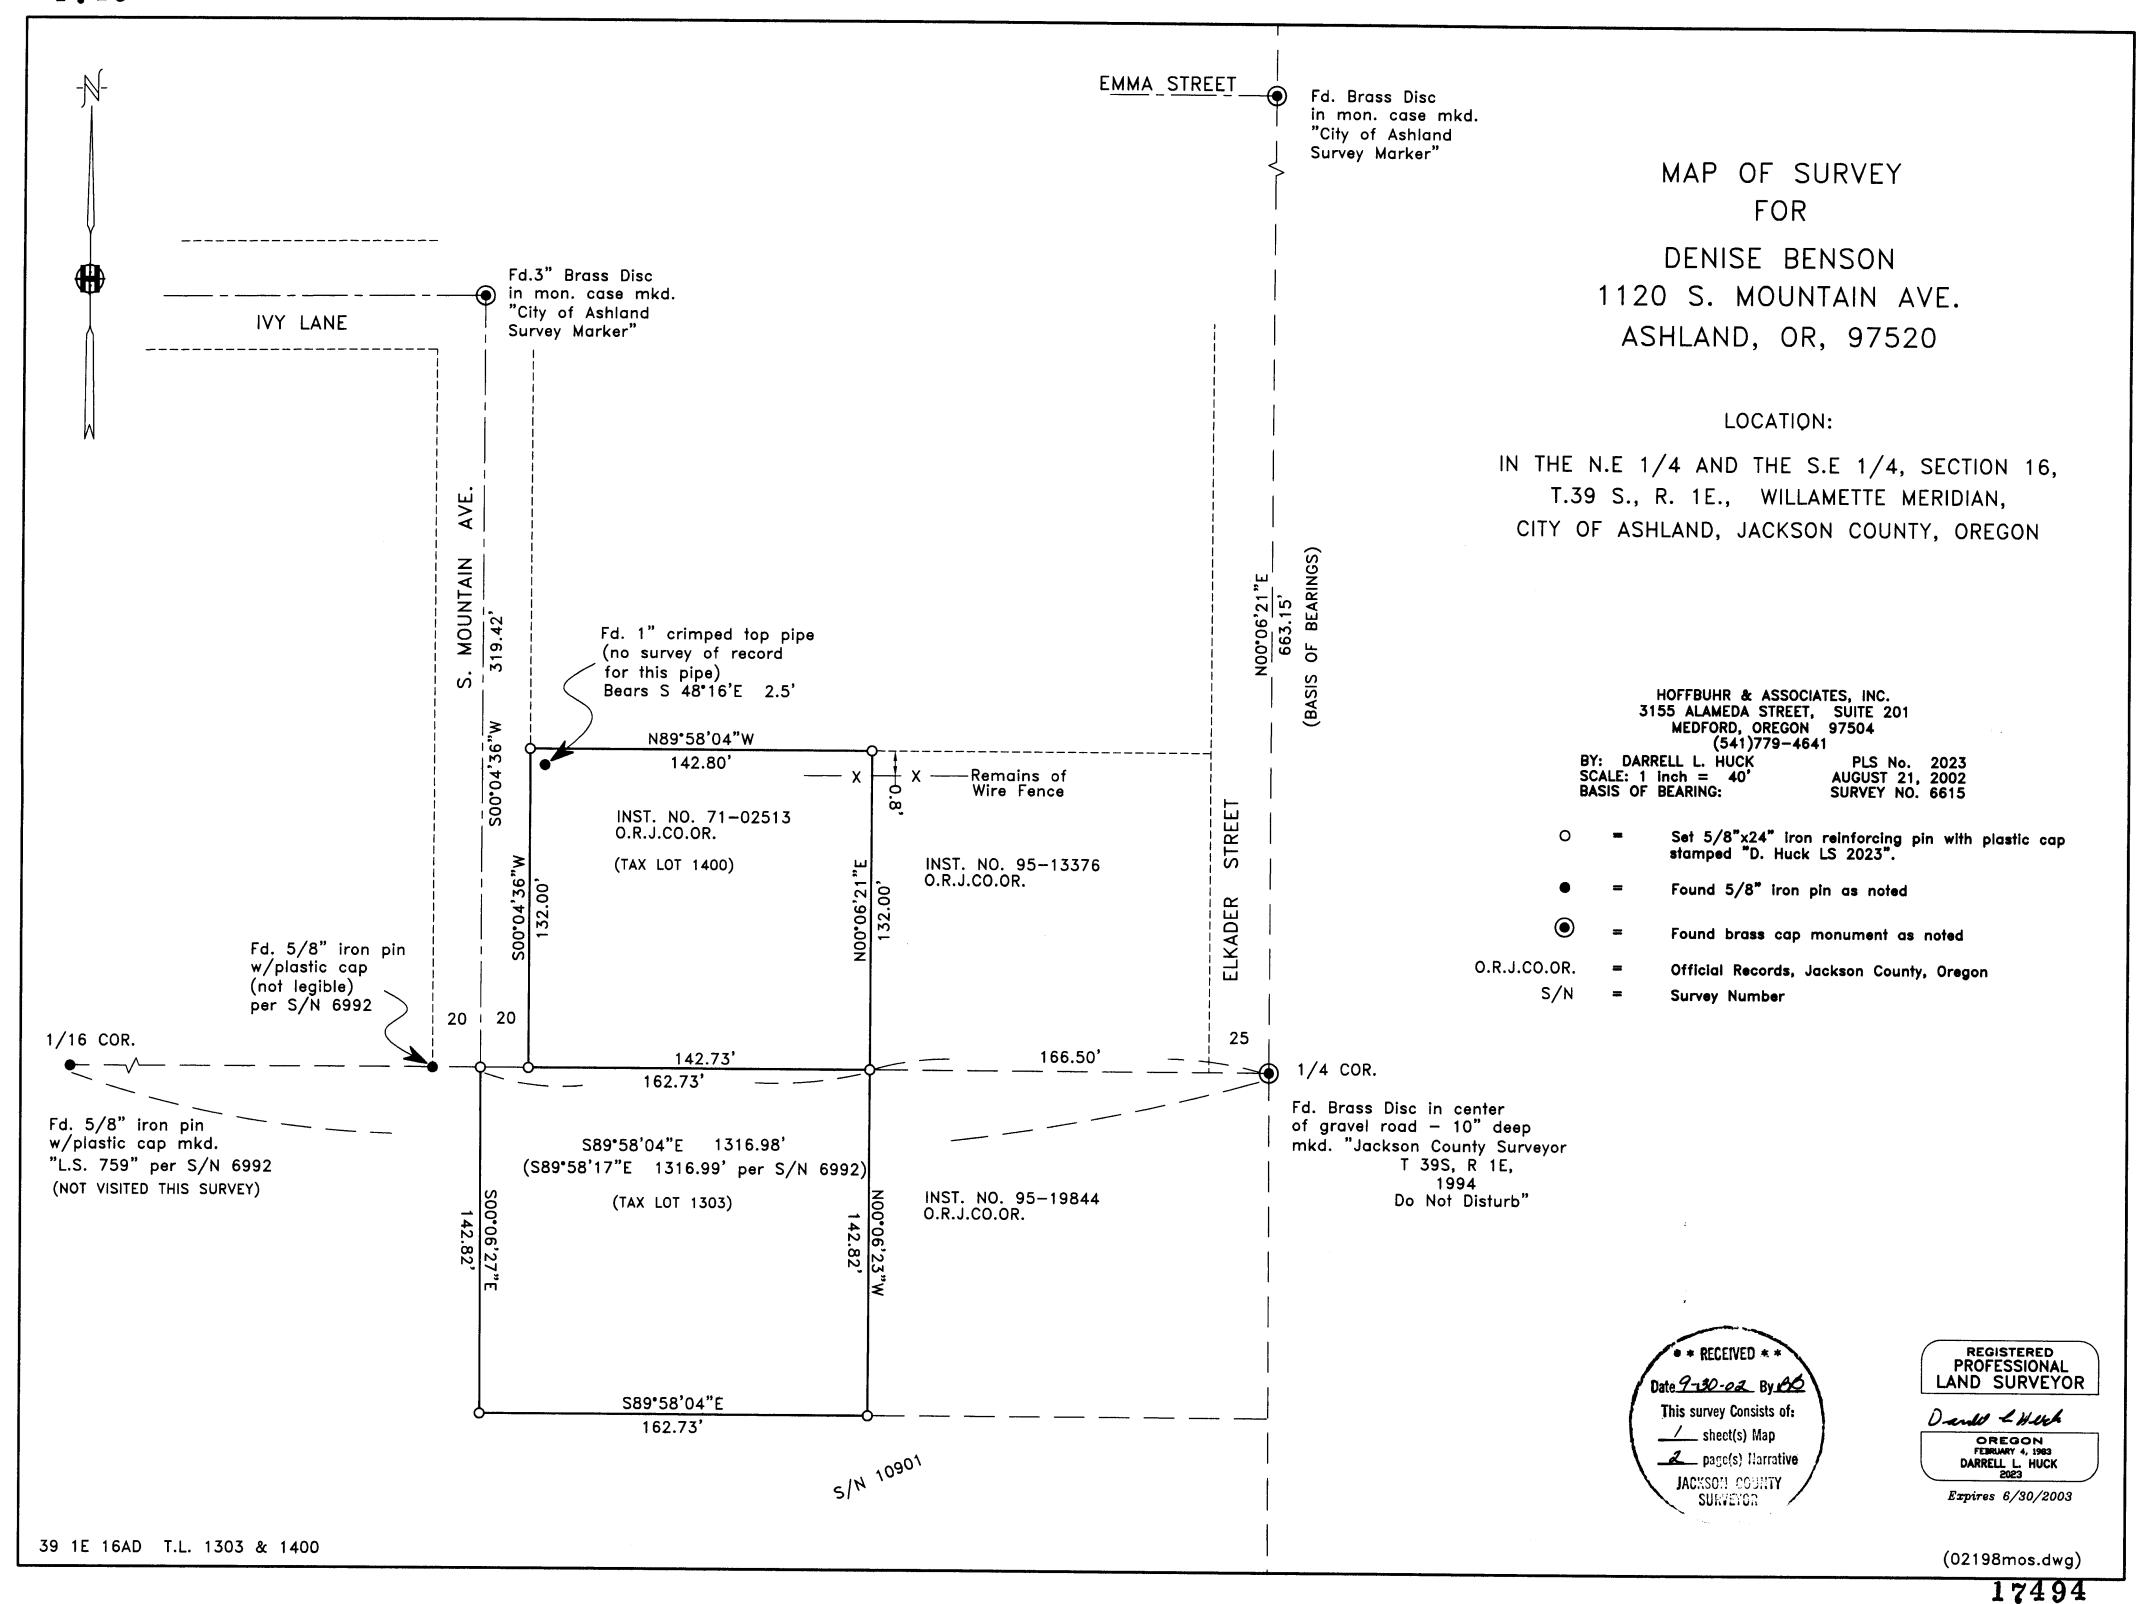

Now then, regarding the location of tax lot 1303 as described in Instrument No. 76-04005. The point of beginning of this tax lot is "the Southeast corner" of tract conveyed pursuant to Instrument No. 76-03760, which Instrument has been determined to be erroneous as cited above. If this point of beginning is held a 1.00' deed gap would be created between tax lot 1303 and the adjoining tax lot 1302 to the east.

After reviewing deeds of record it is apparent that there is an intent for the Northeast corner of tax lot 1303 to be common with the Southeast corner of tax lot 1400. I therefore held the west line of the property adjoining to the east and described in Instrument No. 95-19844 to control the east boundary of tax lot 1303.

BASIS OF BEARING: SURVEY NO. 6615

DATE: August 21, 2002

REGISTERED
PROFESSIONAL
LAND SURVEYOR

Danell L Huck

OREGON FEBRUARY 4, 1963 DARRELL L HUCK 2023

Darrell L. Huck L.S. 2023 - Oregon Expires 06/30/03

(02198nar)

