SURVEY FOR: Jeanne Sander 3606 Bursell Rd. Central Point, OR. 97502

LOCATION:

Lots 6, 7 & 8 of AMENDED PLAT of lots 3 to 10 inclusive of PITT VIEW SUBD. and in the NE1/4 of Section 11, T.37S.,R.2W., W.M., City of Central Point, Jackson County, Oregon

SURVEY BY: Kaiser Surveying 19440 Highway 62 Eagle Point, OR. 97524

DATE: March 25, 2002

PROFESSIONAL
LAND SURVEYOR

OREGON
JULY 16, 1967
GARY D. KAISER
No. 803
EXP. 6-30-03


This survey Consists of:

______sheet(s) Map
_____page(s) Narrative

JACKSON COUNTY
SURVEYOR

LEGEND

- Found 5/8" Rebar with Plastic Cap S.N. 16059
- Set 5/8" x 24" Rebar with Plastic Cap marked "KAISER RLS 803"
- S.N. = Filed Survey Number County Surveyors Office
- () = Record AMENDED PLAT of Lots 3 to 10 inclusive of PITT VIEW SUBDIVISION

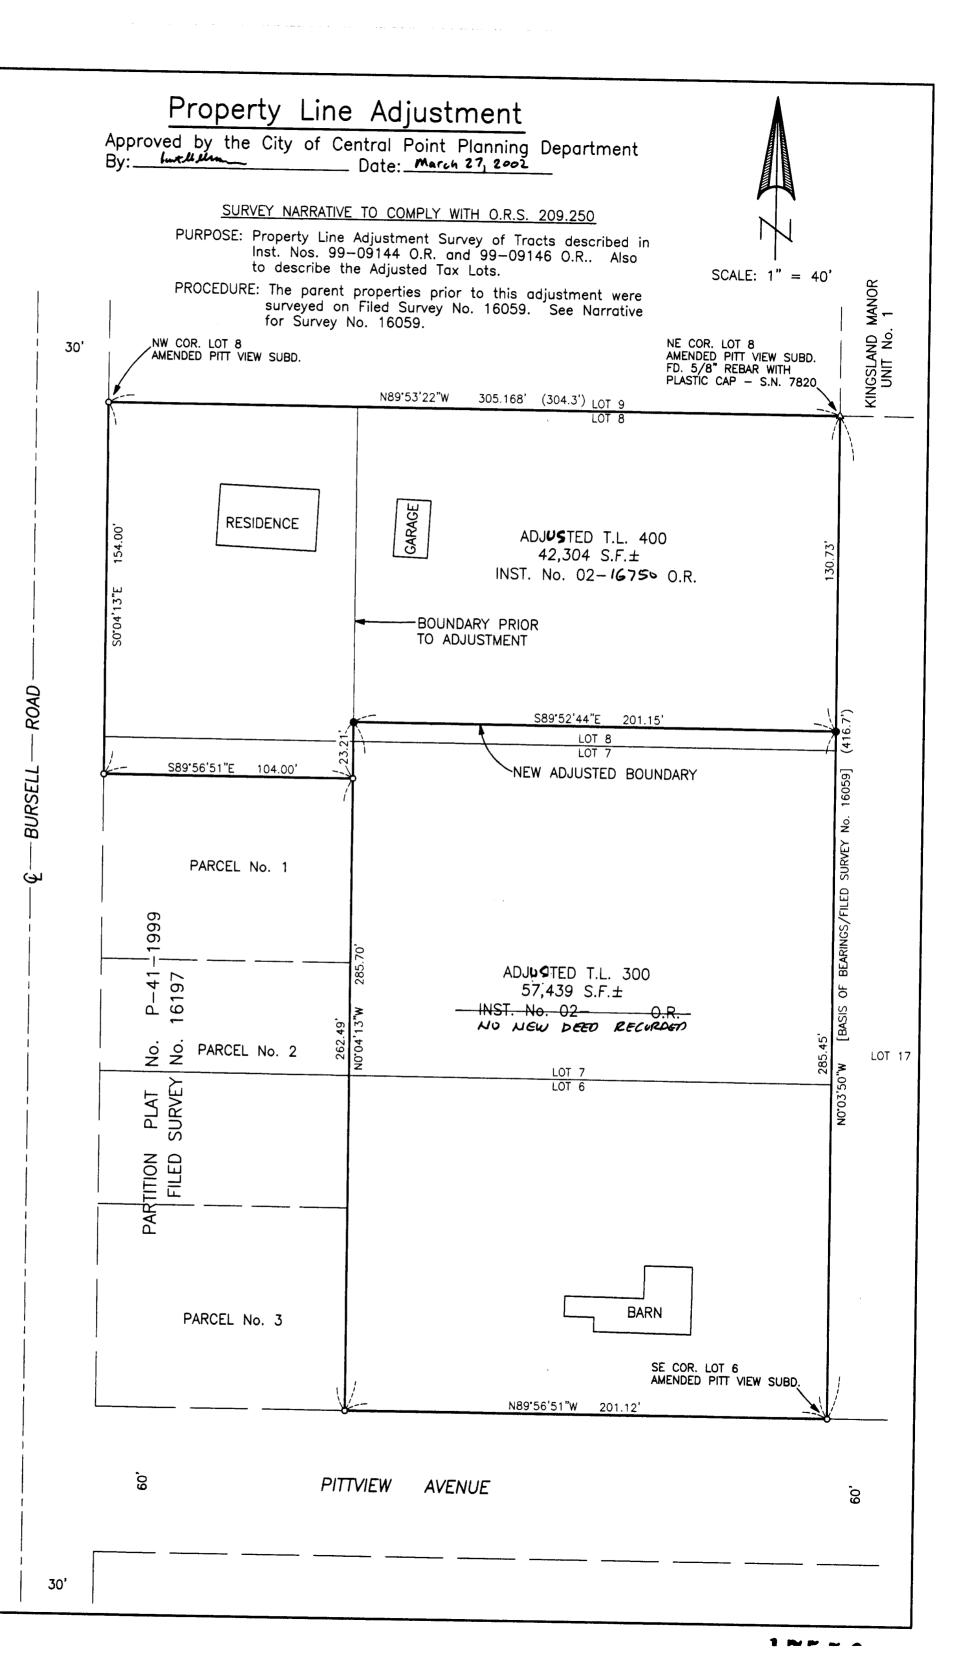

T.L. No. 372W 11AC - 200, 300 & 400