


SURVEY FOR:
 George and Kim Petersen
 1001 Old Trail Creek Road
 Trail, OR. 97541

SURVEY BY:
 Kaiser Surveying
 19440 Highway 62
 Eagle Point, OR. 97524

LOCATION:
 S.E. 1/4 of Section 33,
 T.33S., R.1W., W.M.,
 Jackson County, Oregon

DATE:
 January 8, 2003

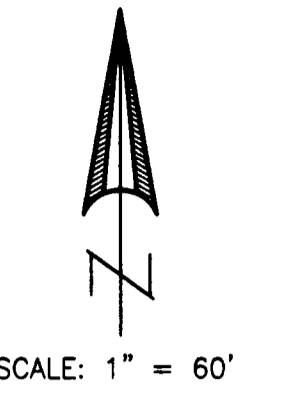

SURVEY NARRATIVE TO COMPLY WITH O.R.S. 209.250

PURPOSE: Boundary Survey of Tract described in Inst. No. 87-14514 O.R.
 PROCEDURE: Aliquot parts of Section 33 were located from information on Filed Survey Nos. 13959 and 11623. Field ties were made to the average center of Trail Creek.

LEGEND

- o = Found 5/8" Rebar with Plastic Cap - S.N. 13959
- = Set 5/8" x 24" Rebar with Plastic Cap marked "KAISER RLS 803"
- S.N. = Filed Survey Number
County Surveyors Office
- W.C. = Witness Corner
- x-x- = Fence

REGISTERED
**PROFESSIONAL
 LAND SURVEYOR**
G. Kaiser
 OREGON
 JULY 16, 1967
 GARY D. KAISER
 No. 803
 EXP. 6-30-03

** RECEIVED **
 Date 1-8-03 By AK
 This survey consists of:
1 sheet(s) Map
0 page(s) Narrative
 JACKSON COUNTY
 SURVEYOR