

OREGON CORNER RESTORATION FORM

Section 9 Township 36S Range 3E

County JACKSON Date 7/18/02

Corner Designation

T36S R3E	
S4	S3
S9	S10

- Condition Report Only
- Not Found
- Renewed
- Unrecorded
- Surveyed In
- Referenced Out


Previous Renewals/Surveys, etc.

RENEWED IN HAROLD CENTER 1978 SURVEY # 7056


Monument(s) & Accessories Found: (Condition and Source)

- FOUND 1962 BLM BCIP IN GOOD CONDITION
- 18" PINE STUMP BEARS S82°34'W 23.2 FEET (RECORDED S83°12'W 22.78 FT) AXE W/DR
- 12" YEW BEARS S64°16'E 32.3 FEET (RECORDED S63°56'E 32.50 FT) VISIBLE SCRIBING & TAG
- ROOT REMAINS BEAR S17°E 22.4 FEET AX PSE RECORDED
- 10" FIR WITH RECORDED BEAR AND DISTANCE OF N32°20'W 33.25 FT IS DOWN & UNPROTECTED
- 11" CEDAR BEARS N24°34'W 19.5 FT (NO RECORD) PARTIAL VISIBLE SCRIBING

Monument Detail

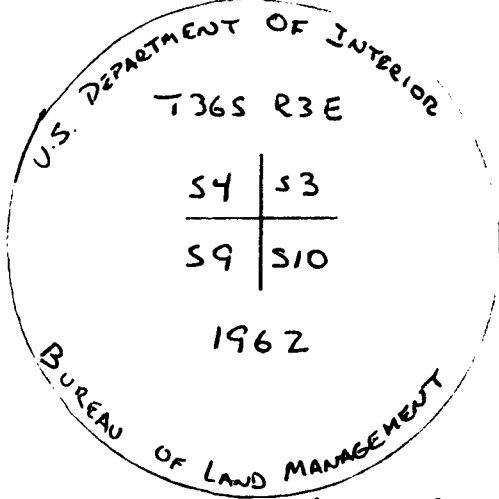

Sketch

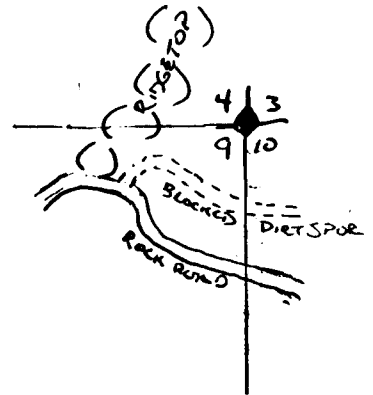

Monument Set (Procedures and Description)

\_\_\_\_\_  
 \_\_\_\_\_  
 \_\_\_\_\_

New Accessories

9" FIR BEARS S11°4'W 11.2 FEET W/ SCRIBE T36S R3E S9 BT AND TAG TREE

Location & Comments

CORNER LIES APPROX 150 FT EAST OF RIDGETOP AND APPROX 200 FT NORTH OF DIRT SPUR ROAD

Compass Declination 19 1/2°  
 Firm/Agency LONG ROCK TIMBER COMPANY  
 Address P.O. BOX 1127 ROSSBUEG, ORS 97470  
 Party Chief GARY ANGLETT  
 Notes GARY ANGLETT  
 Witness MARIC DVORSCAK

Surveyor's Se

REGISTERED PROFESSIONAL LAND SURVEYOR

Ken W. Hoffine  
 OREGON JULY 16, 1987  
 KEN W. HOFFINE  
 2291

Expires 6/30/03

**\*\* RECEIVED \*\***  
 Date 7-25-02 By BD  
 This survey consists of:  
1 page sheet(s) Map  
       page(s) Narrative  
 JACKSON COUNTY SURVEYOR