


**** RECEIVED ****
 Date 2-12-03 By CB
 This survey consists of:
1 sheet(s) Map
0 page(s) Narrative
JACKSON COUNTY
SURVEYOR



MAP
SHOWING A SURVEY IN THE
N.W. 1/4 OF THE S.W. 1/4 OF
SEC. 15, T. 36 S., R. 4 W.
W.M., JACKSON CO., OREGON

SURVEYED FOR:
CARLING OF AMERICA LTD.
C.O. MICHAEL BIRD
612 5th STREET
GRANTS PASS, OREGON

SURVEYED BY:
MAX H. HULL SURVEYING
231 N.W. "B" STREET
GRANTS PASS, OREGON

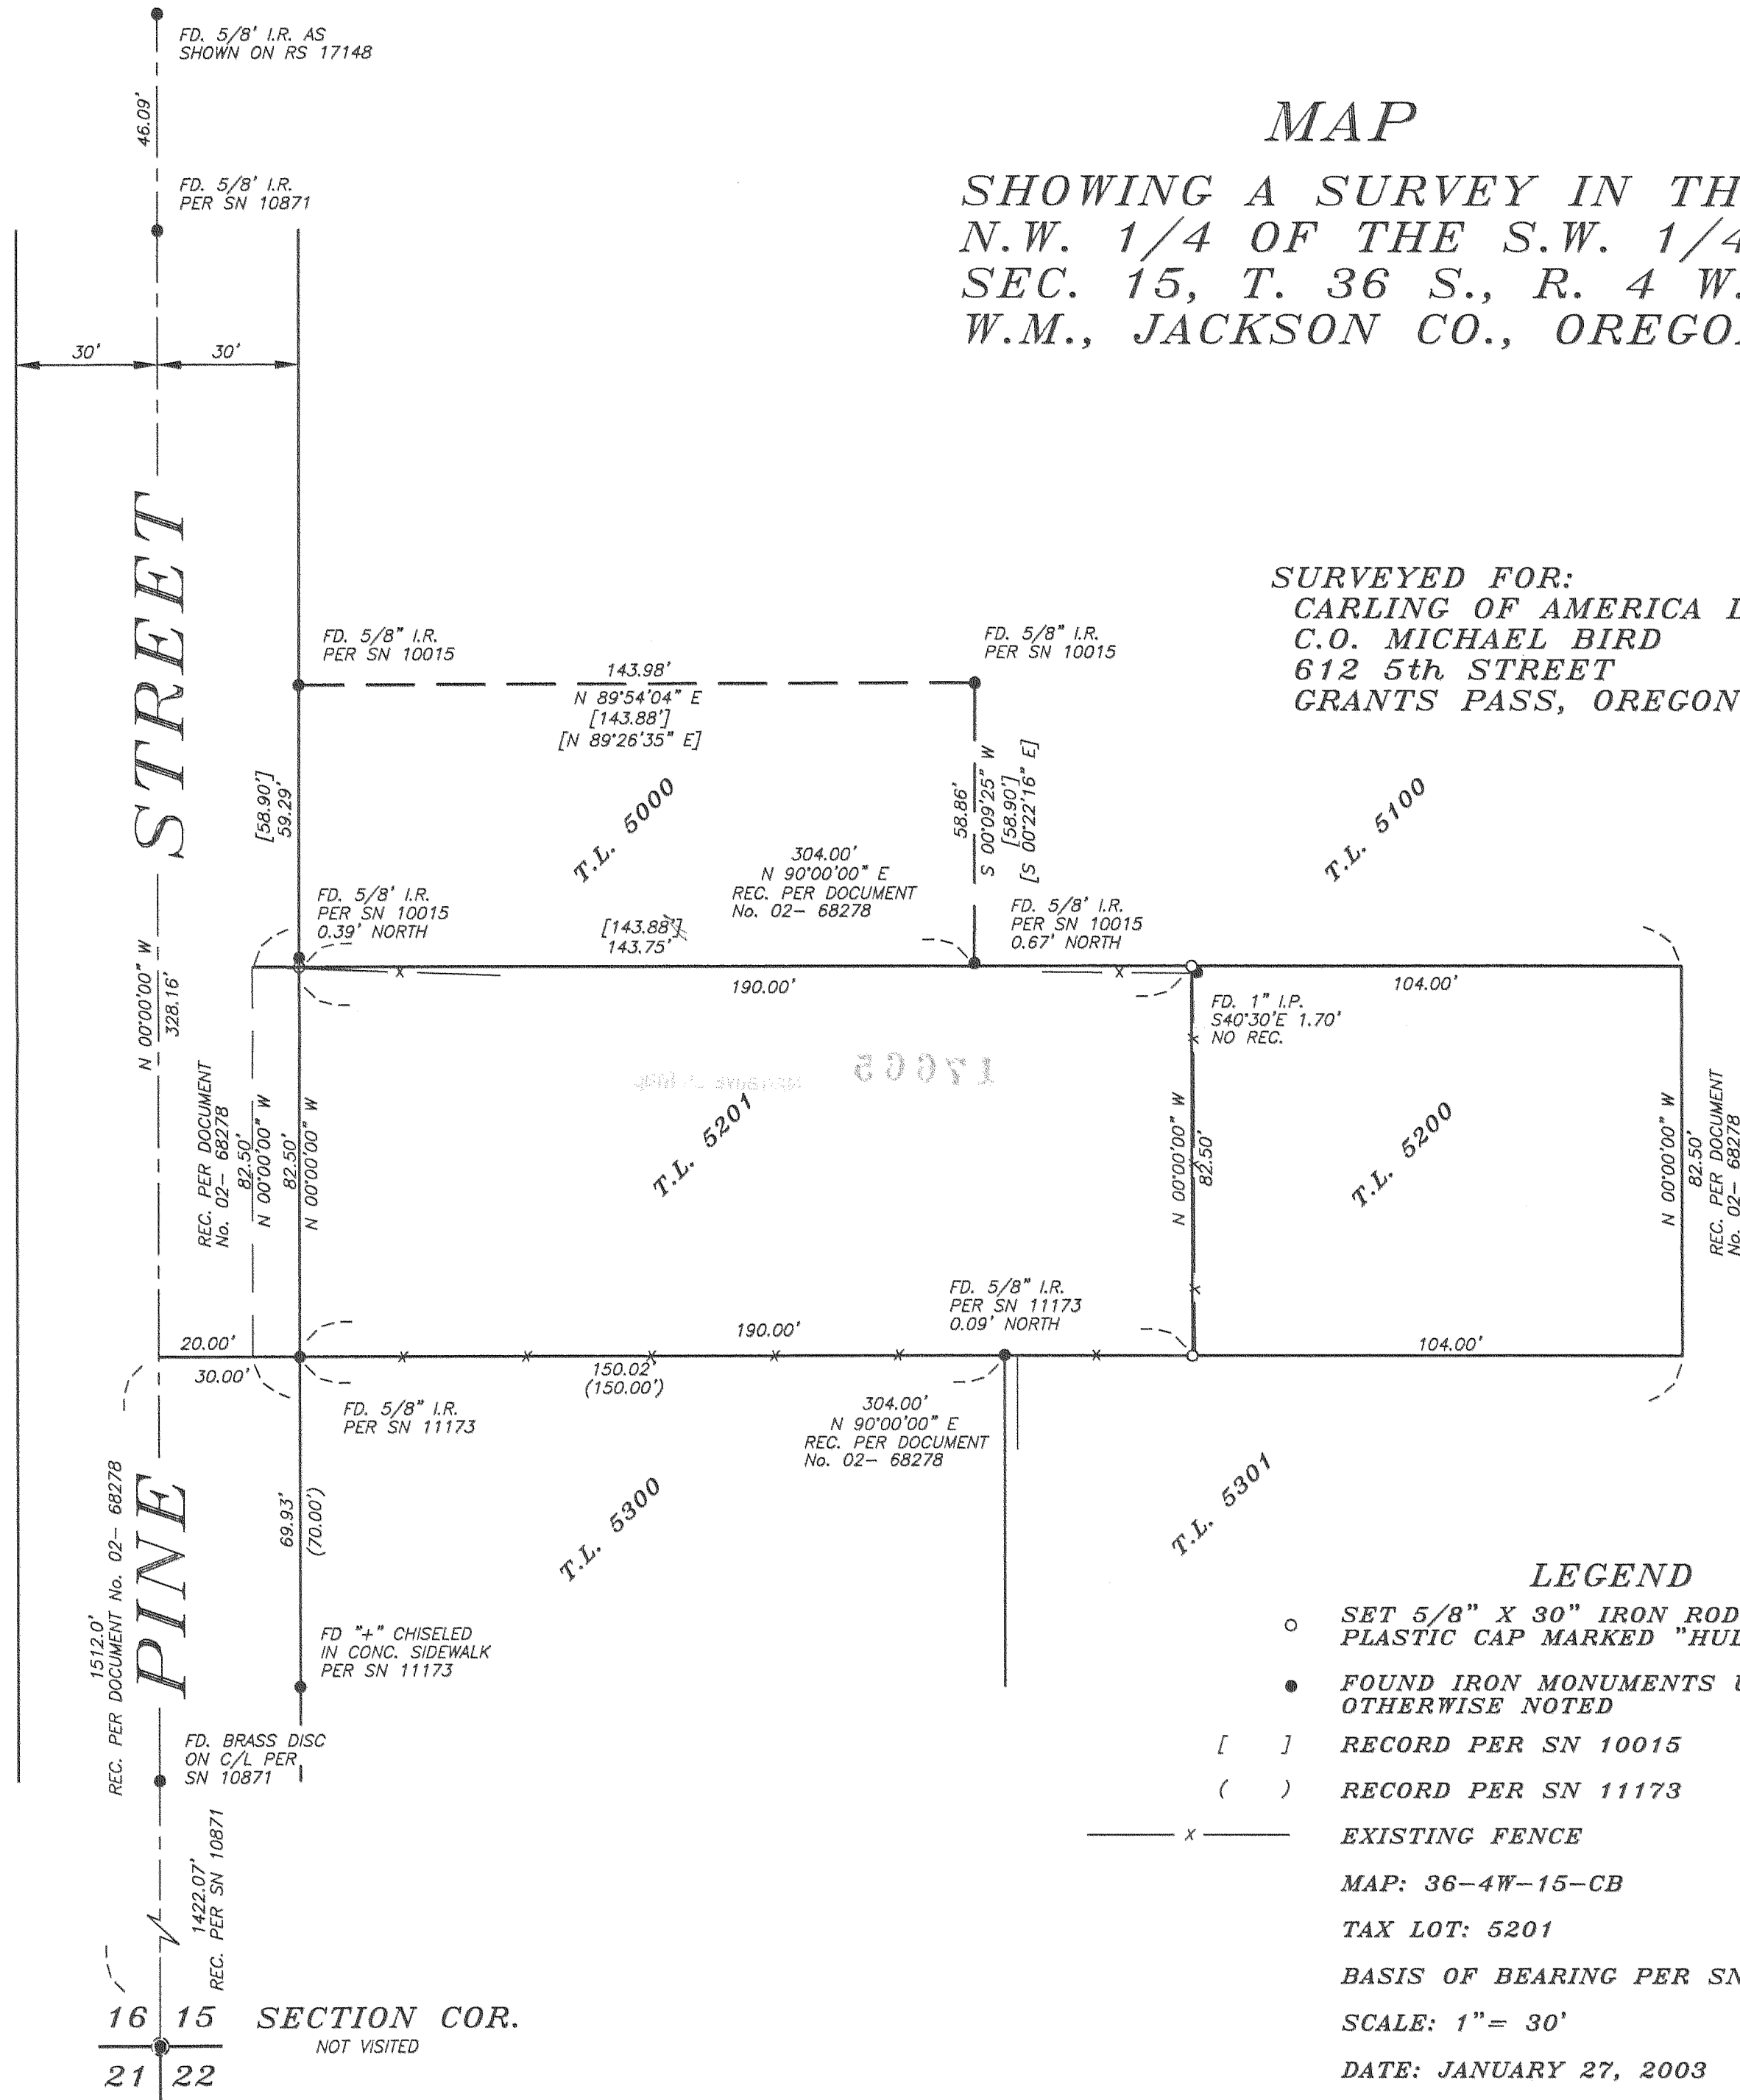

NARRATIVE
 THE PURPOSE OF THIS SURVEY IS TO SURVEY AND MONUMENT THE BOUNDARIES OF THAT PROPERTY DESCRIBED IN DOCUMENT NO. 02-68278 OF THE JACKSON COUNTY DEED RECORDS; THENCE USING SAID DEED AND MONUMENTS AS SHOWN FOUND ON THE MAP, I SURVEYED AND MONUMENTED THE PROPERTY AS INDICATED. THE SURVEY WAS CONDUCTED WITH A NIKON DTM-420 TOTAL STATION.

LEGEND

- SET 5/8" X 30" IRON ROD WITH YELLOW PLASTIC CAP MARKED "HULL RS 901"
- FOUND IRON MONUMENTS UNLESS OTHERWISE NOTED
- [] RECORD PER SN 10015
- () RECORD PER SN 11173
- x — EXISTING FENCE

MAP: 36-4W-15-CB
 TAX LOT: 5201
 BASIS OF BEARING PER SN 11173
 SCALE: 1" = 30'
 DATE: JANUARY 27, 2003

REGISTERED
 PROFESSIONAL
 LAND SURVEYOR
 OREGON
 JULY 11, 1969
 MAX H. HULL
 901
 RENEW: JUNE 30, 2003