


MAP OF SURVEY

FOR
BILL CRONIN, 318 BRIDGE ST.
ASHLAND, OREGON.

IN N 1/2 OF SW 1/4 SEC. 6 T. 39 S. R. 1 E. W. M.
DATE: 8-18-61 SCALE: 1"=200'
SOLAR BEARINGS

REGISTERED
OREGON
LAND SURVEYOR

L. E. Ager
MARCH 10, 1944
L. E. AGER
21

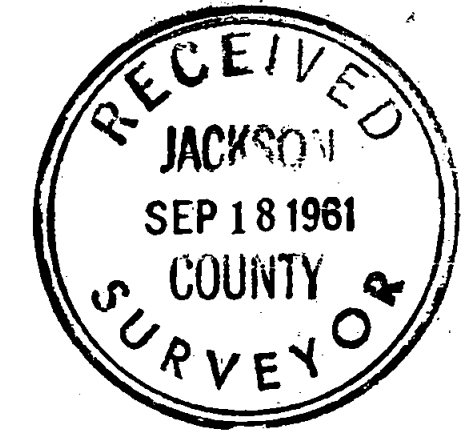

N.W. COR.
SEC. 6

3/4" I.P.
SET BY MCCALL 1889

W 1/4 COR.
3/4" I.P.
OLD BTs.
R.F. STUMP &
REM. LAUREL

GAS PIPE BY MCCALL
DESTROYED BY LOGGERS.

S. 89° 52' E. FENCE 2762.2

CENTER SEC. 6

OLD 3/4" I.P.
IN FENCE COR.
MCCALL 1889

N.E. 1/4 OF SW 1/4

GOV. LOT 6

N. 0° 14' E.
1321.8

S. 64° 00' W. 1728.

N. 62° 00' W. 1114.3

S. 0° 17' W. 1071.0
FENCE 1224

WEST 213.3

N. 0° 17' E. 153.2

WEST 12.7

1/16 COR.
3/4" I.P.

1321.8

STONE
MCCALL
1889

S.W. COR SEC. 6
2" I.P. & 3 ORIG. BTs.

S 1/4 COR.
SEC. 6

MCCALL 1889
1 1/2" CARRIAGE
AXLE 1 ORIG. BT.

Survey narrative to comply with ORS 209-250, Oregon State Law of 1947

For: Bill Cronin, 318 Bridge St. Ashland, Oregon.

Purpose: To mark the boundaries of and describe tract shown on map

Procedure: Set a 2" iron pipe for Southwest corner of Section from
Orig. B.Ts: Y.P in SE Quad. 1 Oak in NW Quad. 1 Oak in
NE Quad.
West $\frac{1}{4}$ cor. found RF stump of orig. BT & remains of Laurel
B.T. from which I set a $\frac{3}{4}$ " iron pipe for corner.
On true line between these corners I set a $\frac{3}{4}$ " iron pipe
for the $\frac{1}{16}$ corner.
This Section was subdivided by McCall in 1889 and his
notes show and describe corners set by him at that time
which I have found in place except the gas pipe for the
West $\frac{1}{4}$ corner. Rather than resubdivide the Section I used
his monuments as the old fences for property divisions
are on his established lines. I have found all corners
set by McCall shown on this map which are in place and
my survey is as shown on the accompanying map.

REGISTERED
OREGON
LAND SURVEYOR

L. E. Ager
MARCH 10, 1944
L. E. AGER
21

