

N



19

20

Found Brass
Cap in Hy.

30

29

RECORD OF SURVEY
MADE TO ESTABLISH THE NORTH
1/16 CORNER BETWEEN SEC. S
29 & 30, T. 36 S., R. 4 W., W.M.,
JACKSON COUNTY, OREGON.

SEPT. 1961

SCALE 1"=300'

RECORD
BEARING OF
SEC. LINE.


1327 73

FOR

F. J. MURPHY
4235 SO. PACIFIC HIGHWAY
GRANTS PASS, OREGON

Scribed B.t.s
14" White Oak
bears N20°E 142' 0" Set 1/2" I.P.
14" White Oak
bears N56°30'W 16'

1327 73

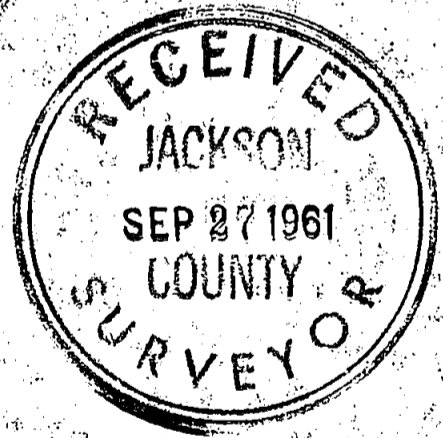

30

29

Found 1" I.P. and B.T.s
as re-established by
C.S.

REGISTERED
OREGON
LAND SURVEYOR

Claude E. Masters

OCTOBER 24, 1958
CLAUDE E. MASTERS
457

No Narrative

