17704

MAP OF SURVEY
PROPERTY LINE ADJUSTMENT

LOCATED IN
LOTS 10, 11 & 12 IN BLOCK 41 OF THE
RAILROAD ADDITION TO THE CITY OF PHOENIX
in the
SOUTHEAST 1/4 of
SEC. 9, T38S, R1W, W.M.
JACKSON COUNTY, OREGON

MARCH 12, 2003

SURVEY FOR

Gary & Claire Almquist
P.O. Box 860
Talent, OR 97540

GRAPHIC SCALE

30 0 15 30

(IN FEET)
1 inch = 30 ft.

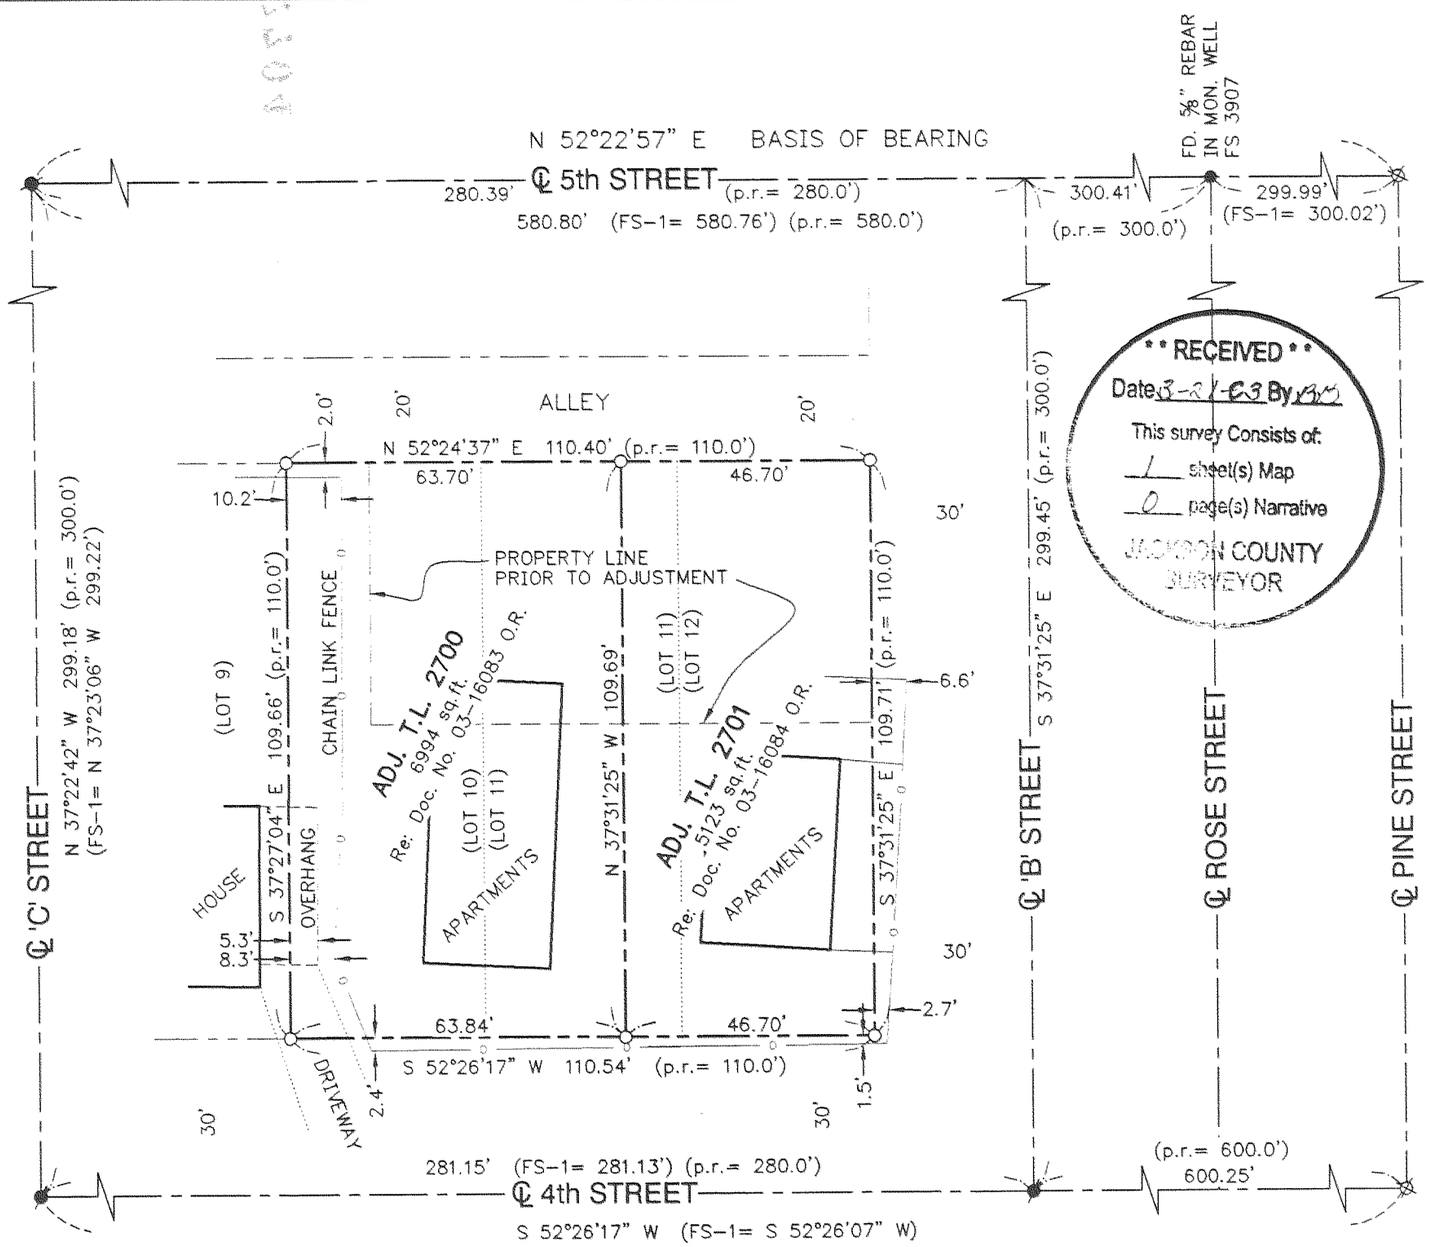

**** RECEIVED ****
Date 3-21-03 By
This survey Consists of:
1 sheet(s) Map
0 page(s) Narrative
JACKSON COUNTY SURVEYOR

NARRATIVE

PURPOSE: To survey and monument the adjusted property line as per owner's request.

PROCEDURE: Found record survey monuments as shown hereon and monumented the new property line accordingly.

BASIS OF BEARINGS: Found centerline monuments along 5th Street per Filed Survey No. 14750

LEGEND

- O = SET 5/8" X 24" REBAR & ORANGE PLASTIC CAP STAMPED "HARDEY ENG & ASSOC"
- ● = FOUND MONUMENT PER FS-1
- ⊗ = FOUND MONUMENT PER FS-2
- FS-1 = FILED SURVEY No. 14750
- FS-2 = FILED SURVEY No. 9930
- FS = FILED SURVEY
- p.r. = PLAT RECORD
- — — — = PROPERTY LINE
- ——— ○ ——— = CHAIN LINK FENCE

APPROVAL

Examined and approved by the City of Phoenix Planning Dept. this 20 day of MARCH, 2003.

Denis Murray
City Planner

REGISTERED
PROFESSIONAL
LAND SURVEYOR
Richard L. Bath
OREGON
JULY 30, 1976
RICHARD L. BATH
No. 1069
RENEWS 12/31/03

Hardey Engineering & Associates, Inc.
HEA
ENGINEERING INTEGRITY
P.O. BOX 1625
MEDFORD, OREGON 97501-0063
VOICE: 541-772-6880
FAX: 541-772-9573
EMAIL: info@hea-inc.com

38 1W 09DC, TL's 2700 & 2701

17704