


1771

Survey For
J.A. WOODS
Located in Sec. 36, T. 36 S., R. 2 W., W.M.
By: Mark E. Boyden
Sept., 1961

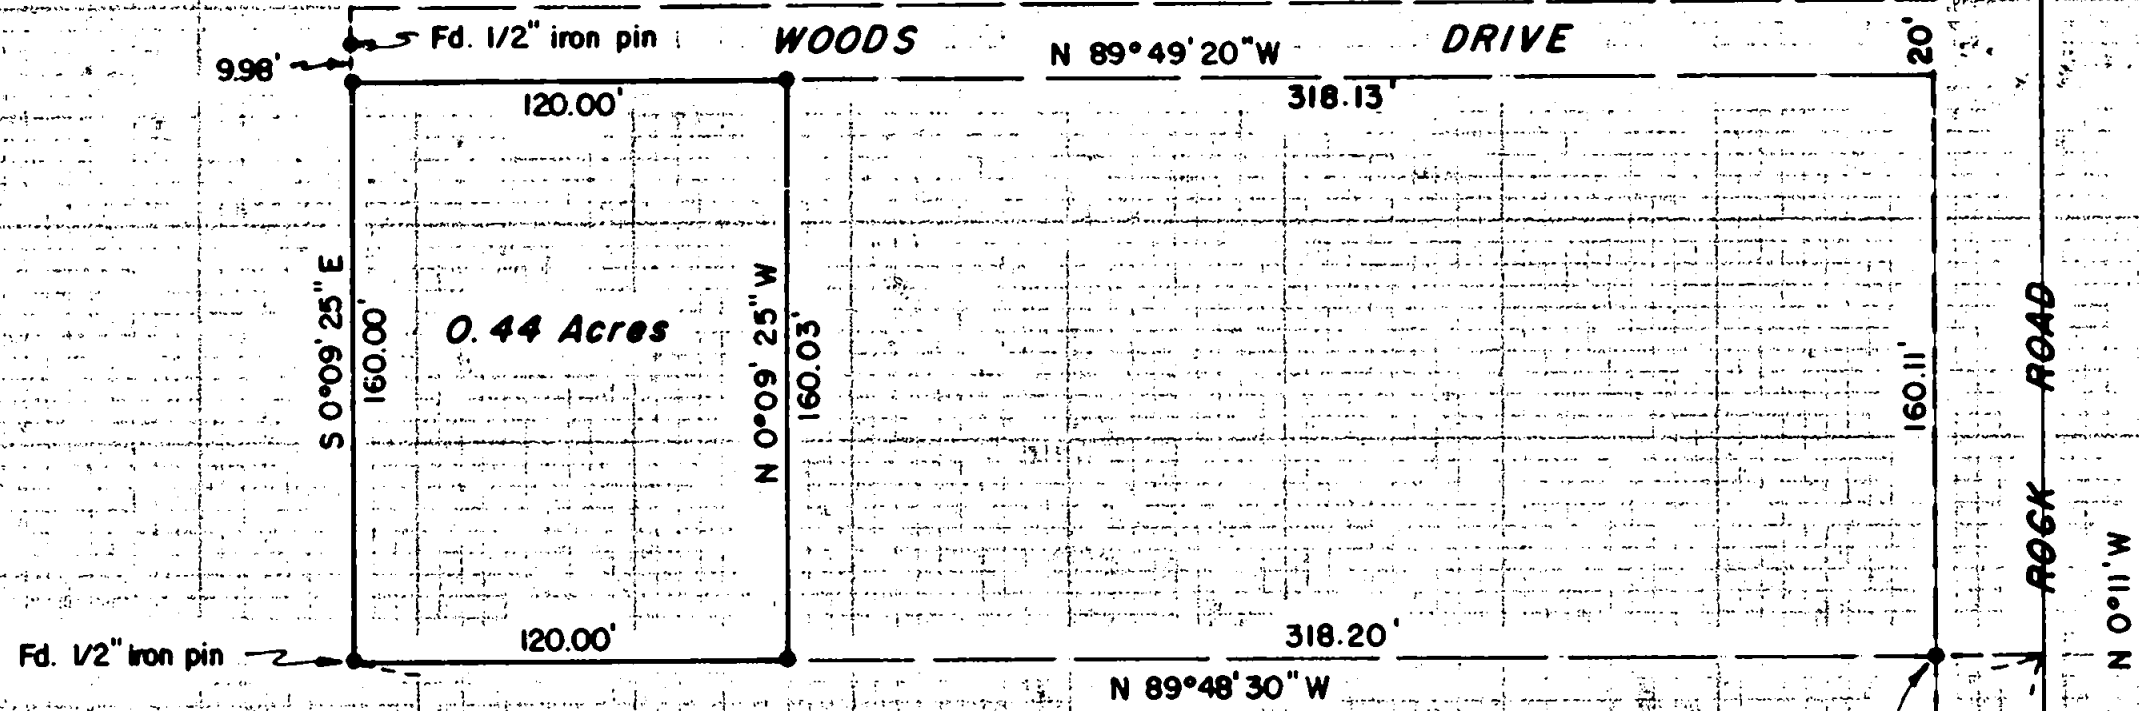


REGISTERED
OREGON
LAND SURVEYOR

Mark E. Boyden
NOVEMBER 9 1961
MARK E. BOYDEN
281

Scale: 1" = 60'

- ⊙ Re-estab. Gov't. cor.
- Fd. iron pin set on Recorded Survey No. 397.
- Set 5/8" iron pin

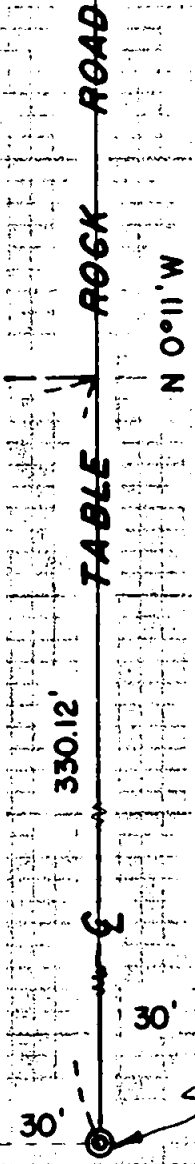

South 1/4 cor. Sec. 36
Fd. 1" iron pipe

1771

Survey No. 1771

SURVEY NARRATIVE TO COMPLY WITH O.R.S. 209.250.

FOR: J. A. Woods
5077 Tablerock Road
Medford, Oregon

PURPOSE: To monument and describe a 120.00 foot lot lying at the West end of that 1.81 acre parcel previously monumented by this office (See Recorded Survey No. 397), excepting the Northerly 20.00 feet which has been deeded to Jackson County for road purposes and recorded in Volume 378, Page 202 of the Deed Records.

PROCEDURE:

Found iron pin monuments previously set on Recorded Survey No. 397, setting 5/8" iron pins for the additional lot corners as shown.

September 1961

