

03 20021

17720⁴⁷¹

2:15 10
10
11

AFFIDAVIT OF MONUMENTATION
FOR DEFERRED MONUMENTS

KNOW ALL MEN BY THESE PRESENTS, that I, Stephan L. Barott, a duly Registered Professional Land Surveyor of the State of Oregon, do hereby affirm that I have established the lot corners shown as deferred on the Official plat of "POPPY VILLAGE, PHASE I", as recorded in Volume 29 of Plats, Page 11 of records in Jackson County, Oregon and filed in the office of the County Surveyor as survey number 17702. It is to be noted several lot corners land in the concrete curb along private roads. At said points, I set a nail and stainless steel flasher marked "LS 2332"

The location and type of monument set are shown on the attached affidavit, page 2 of 2.


This Affidavit is to comply with Chapter 92.070 of the Revised Statutes of the State of Oregon.

Stephan L. Barott
Stephan L. Barott

April 1, 2003
Date


This certifies that on this 1 day of April, 2003, before me a Notary Public, personally appeared Stephan L. Barott and acknowledged the foregoing instrument to be his voluntary act and deed.

Before me: Patricia L. Thomas

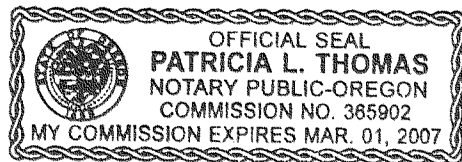

Examined and approved this 1st day of April, 2003.

Gregory Roberts
Jackson County Surveyor

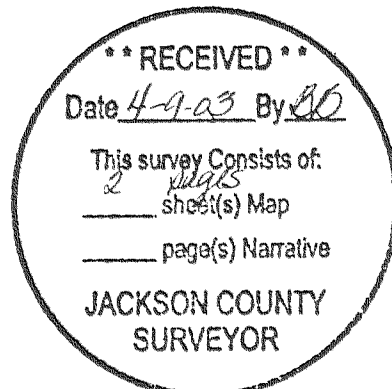

POPPY VILLAGE - PHASE I

DEFERRED MONUMENTS - "AS SET"

AFFIDAVIT OF MONUMENTATION - PAGE 2 OF 2

SHASTA AVENUE

EAGLE POINT GOLF COURSE
D.R. 94-454710

Jackson County, Oregon
Recorded
OFFICIAL RECORDS

APR 01 2003
2:15 PM

Stephan L. Barott
COUNTY CLERK

**** RECEIVED ****
Date 4-9-03 By [Signature]
This survey consists of:
2 pages sheet(s) Map
 page(s) Narrative
JACKSON COUNTY
SURVEYOR

D.R. 75-07883

SEE
DETAIL "A"

REGISTERED
PROFESSIONAL
LAND SURVEYOR

Stephan L. Barott

OREGON
JULY 26, 1998
STEPHAN L. BAROTT
No. 2332

- ☒ CONCRETE NAIL AND STAINLESS STEEL WASHER STAMPED "LS 2332."
- 5/8 IRON PIN W/ RED PLASTIC CAP STAMPED "BAROTT LS 2332."

ALTA VISTA ROAD

03 20021

17720^{all}

215 10
10
11

AFFIDAVIT OF MONUMENTATION
FOR DEFERRED MONUMENTS

KNOW ALL MEN BY THESE PRESENTS, that I, Stephan L. Barott, a duly Registered Professional Land Surveyor of the State of Oregon, do hereby affirm that I have established the lot corners shown as deferred on the Official plat of "POPPY VILLAGE, PHASE I", as recorded in Volume 29 of Plats, Page 11 of records in Jackson County, Oregon and filed in the office of the County Surveyor as survey number 17702. It is to be noted several lot corners land in the concrete curb along private roads. At said points, I set a nail and stainless steel flasher marked "LS 2332"

The location and type of monument set are shown on the attached affidavit, page 2 of 2.


This Affidavit is to comply with Chapter 92.070 of the Revised Statutes of the State of Oregon.

Stephan L. Barott
Stephan L. Barott

April 1, 2003
Date


This certifies that on this 1 day of April, 2003, before me a Notary Public, personally appeared Stephan L. Barott and acknowledged the foregoing instrument to be his voluntary act and deed.

Before me: Patricia L. Thomas

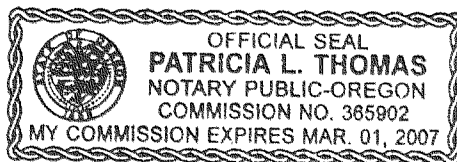

Examined and approved this 1st day of April, 2003.

Robert Roberts
Jackson County Surveyor

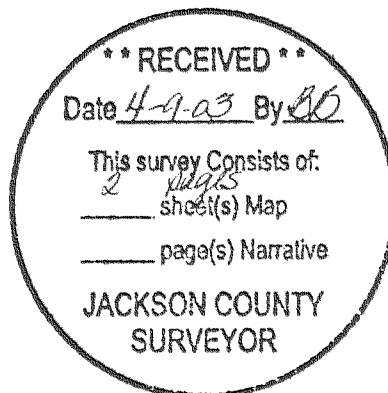

POPPY VILLAGE - PHASE I

DEFERRED MONUMENTS - "AS SET"

AFFIDAVIT OF MONUMENTATION - PAGE 2 OF 2

SHASTA AVENUE

Jackson County, Oregon
Recorded
OFFICIAL RECORDS

APR 01 2003

2:15 PM

Stephan L. Barott
COUNTY CLERK

**** RECEIVED ****

Date 4-9-03 By LS

This survey consists of:
2 pages
sheet(s) Map

page(s) Narrative

JACKSON COUNTY
SURVEYOR

O.R. 75-07365

O.R. 94-04116
EASEMENT GOLF COURSE

SEE
DETAIL "A"

DETAIL "A"

REGISTERED
PROFESSIONAL
LAND SURVEYOR

Stephan L. Barott

OREGON
JULY 26, 1998
STEPHAN L. BAROTT
No. 2332

☒ CONCRETE NAIL AND STAINLESS STEEL WASHER STAMPED "LS 2332."

○ 5/8 IRON PIN W/ RED PLASTIC CAP STAMPED "BAROTT LS 2332."

ALTA VISTA ROAD

03 20021

2