


**SURVEY**  
**R.L. HILL &**  
**THOMAS PROPERTY**  
**D.L.C. 43 T. 38 S. R. 1 W.**  
 JACKSON COUNTY, OREGON  
 SCALE: 1" = 100' HUGH C. INGLE  
 AUG. 1961 CIVIL ENGINEER

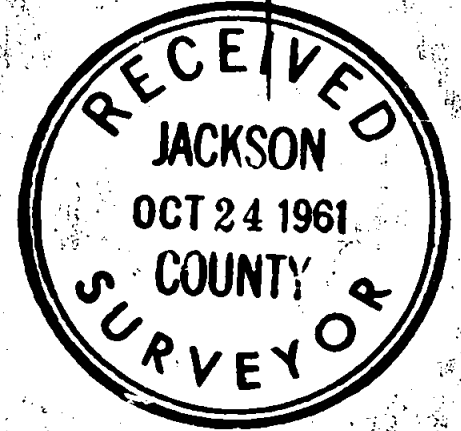

SURVEY NARRATIVE TO COMPLY WITH PARAGRAPH 209.250  
OREGON REVISED STATUTES

FOR: Robert L. Hill.

PURPOSE:

To establish lines and corners for the south portion of that property described in Volume 284, Page 11 of Deed Records of Jackson County, and a partition line across the south portion.

PROCEDURE:

Existing 3/4" pipe monuments were found on the southerly boundary of the North portion of the property and were found to answer correctly to the distances from the North line of D.E.C. # 43. The distance between pipes was found to be correct. The record bearing and distance of this line was used for running out the south portion as shown on the attached map and the parcel was divided by the line shown.

The south line of the survey was found to conform with existing fences and a travelled way.

Sept., 1961

*Hugh C. Ingle*  
Hugh C. Ingle  
Civil Engineer

