

MAP OF SURVEY  
for  
HORIZONTAL CONTROL  
and  
MONUMENT RECOVERY

SITUATED IN  
NW 1/4 of SECTION 30  
T. 37 S., R. 1 W., W.M.  
CITY OF MEDFORD  
JACKSON COUNTY, OREGON



1" = 100'

NARRATIVE

SURVEY FOR: MEDFORD URBAN RENEWAL AGENCY  
45 SOUTH HOLLY ST., MEDFORD, OREGON 97501

PURPOSE: TO REPLACE EXISTING MONUMENTATION WHICH WAS DESTROYED DURING SIDEWALK AND PARKING LOT IMPROVEMENTS ALONG 8TH STREET & HOLLY STREET.

PROCEDURE: PRIOR TO CONSTRUCTION, A CLOSED CONTROL TRAVERSE WAS RUN TYING ALL FOUND PROPERTY CORNER MONUMENTS OF RECORD INTO OUR CONTROL NET. OUR PRIMARY CONTROL POINTS FOR THIS AREA ARE SHOWN ON THIS MAP. DESTROYED MONUMENTS WERE REPLACED IN THEIR ORIGINAL FOUND LOCATION.

BASIS OF BEARINGS: CONTROL NETWORK FOR DOWNTOWN MEDFORD WHICH STARTED IN 1996 AND WAS BASED ON THE BEARING OF MAIN STREET BEING N 54°30'00" E PER S/N 13529.

COORDINATES ARE ASSUMED


DATE: JULY, 2003

POINT COORDINATES

122 N 4383.50 E 9725.75	1491 N 4545.94 E 9949.25 (SN 247)
157 N 4532.95 E 10028.92	1493 N 4441.49 E 9900.91 (SN 4051)

LEGEND

- ⊙ SET LEAD & TACK W/ BRASS TAG MARKED "LS 1069"
- ◁ FOUND .38 CALIBER SHELL CASING FLUSH IN SIDEWALK
- SN = FILED SURVEY No.

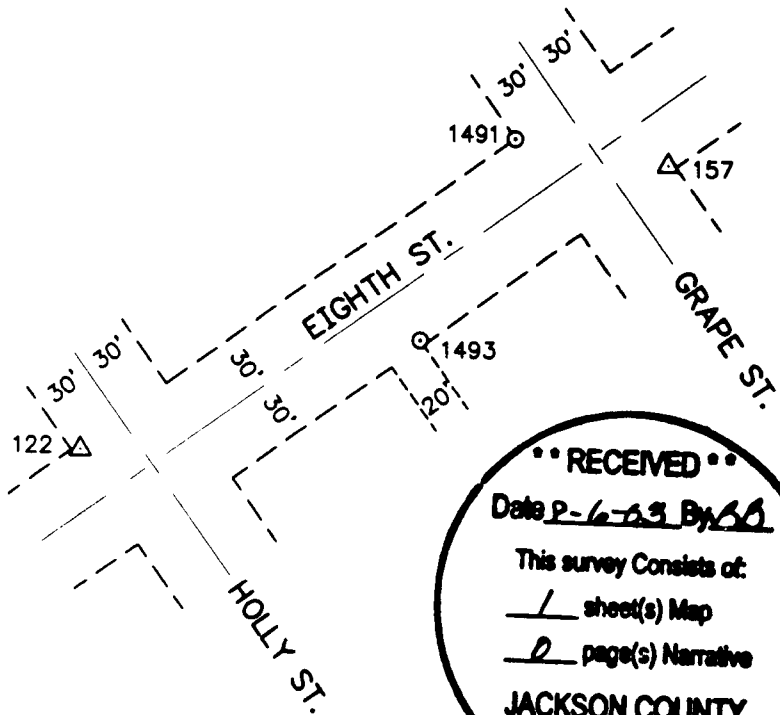

•• RECEIVED ••  
Date 7-6-03 By RSB  
This survey consists of:  
1 sheet(s) Map  
2 page(s) Narrative  
JACKSON COUNTY  
SURVEYOR

REGISTERED  
PROFESSIONAL  
LAND SURVEYOR  
*Richard L. Bath*  
OREGON  
JULY 30, 1976  
RICHARD L. BATH  
No. 1069  
RENEWS 12/31/03

**Hardey Engineering & Associates, Inc.**

**HEA**  
ENGINEERING INTEGRITY

P.O. BOX 1625  
MEDFORD, OREGON 97501-0063  
VOICE: 541-772-6880  
FAX: 541-772-9573  
EMAIL: info@hea-inc.com