MAP OF SURVEY
FOR
RICHARD CLARK
15 HIGHLAND DRIVE
MEDFORD, OR. 97504

LOCATED IN THE N.W. 1/4 SEC. 29,
T.37S., R.1W., W.M.,
CITY OF MEDFORD,
JACKSON COUNTY, OREGON

** RECEIVED **
Date 9-4-03 By BB
This survey Consists of:
1 sheet(s) Map
0 page(s) Narrative
JACKSON COUNTY
SURVEYOR

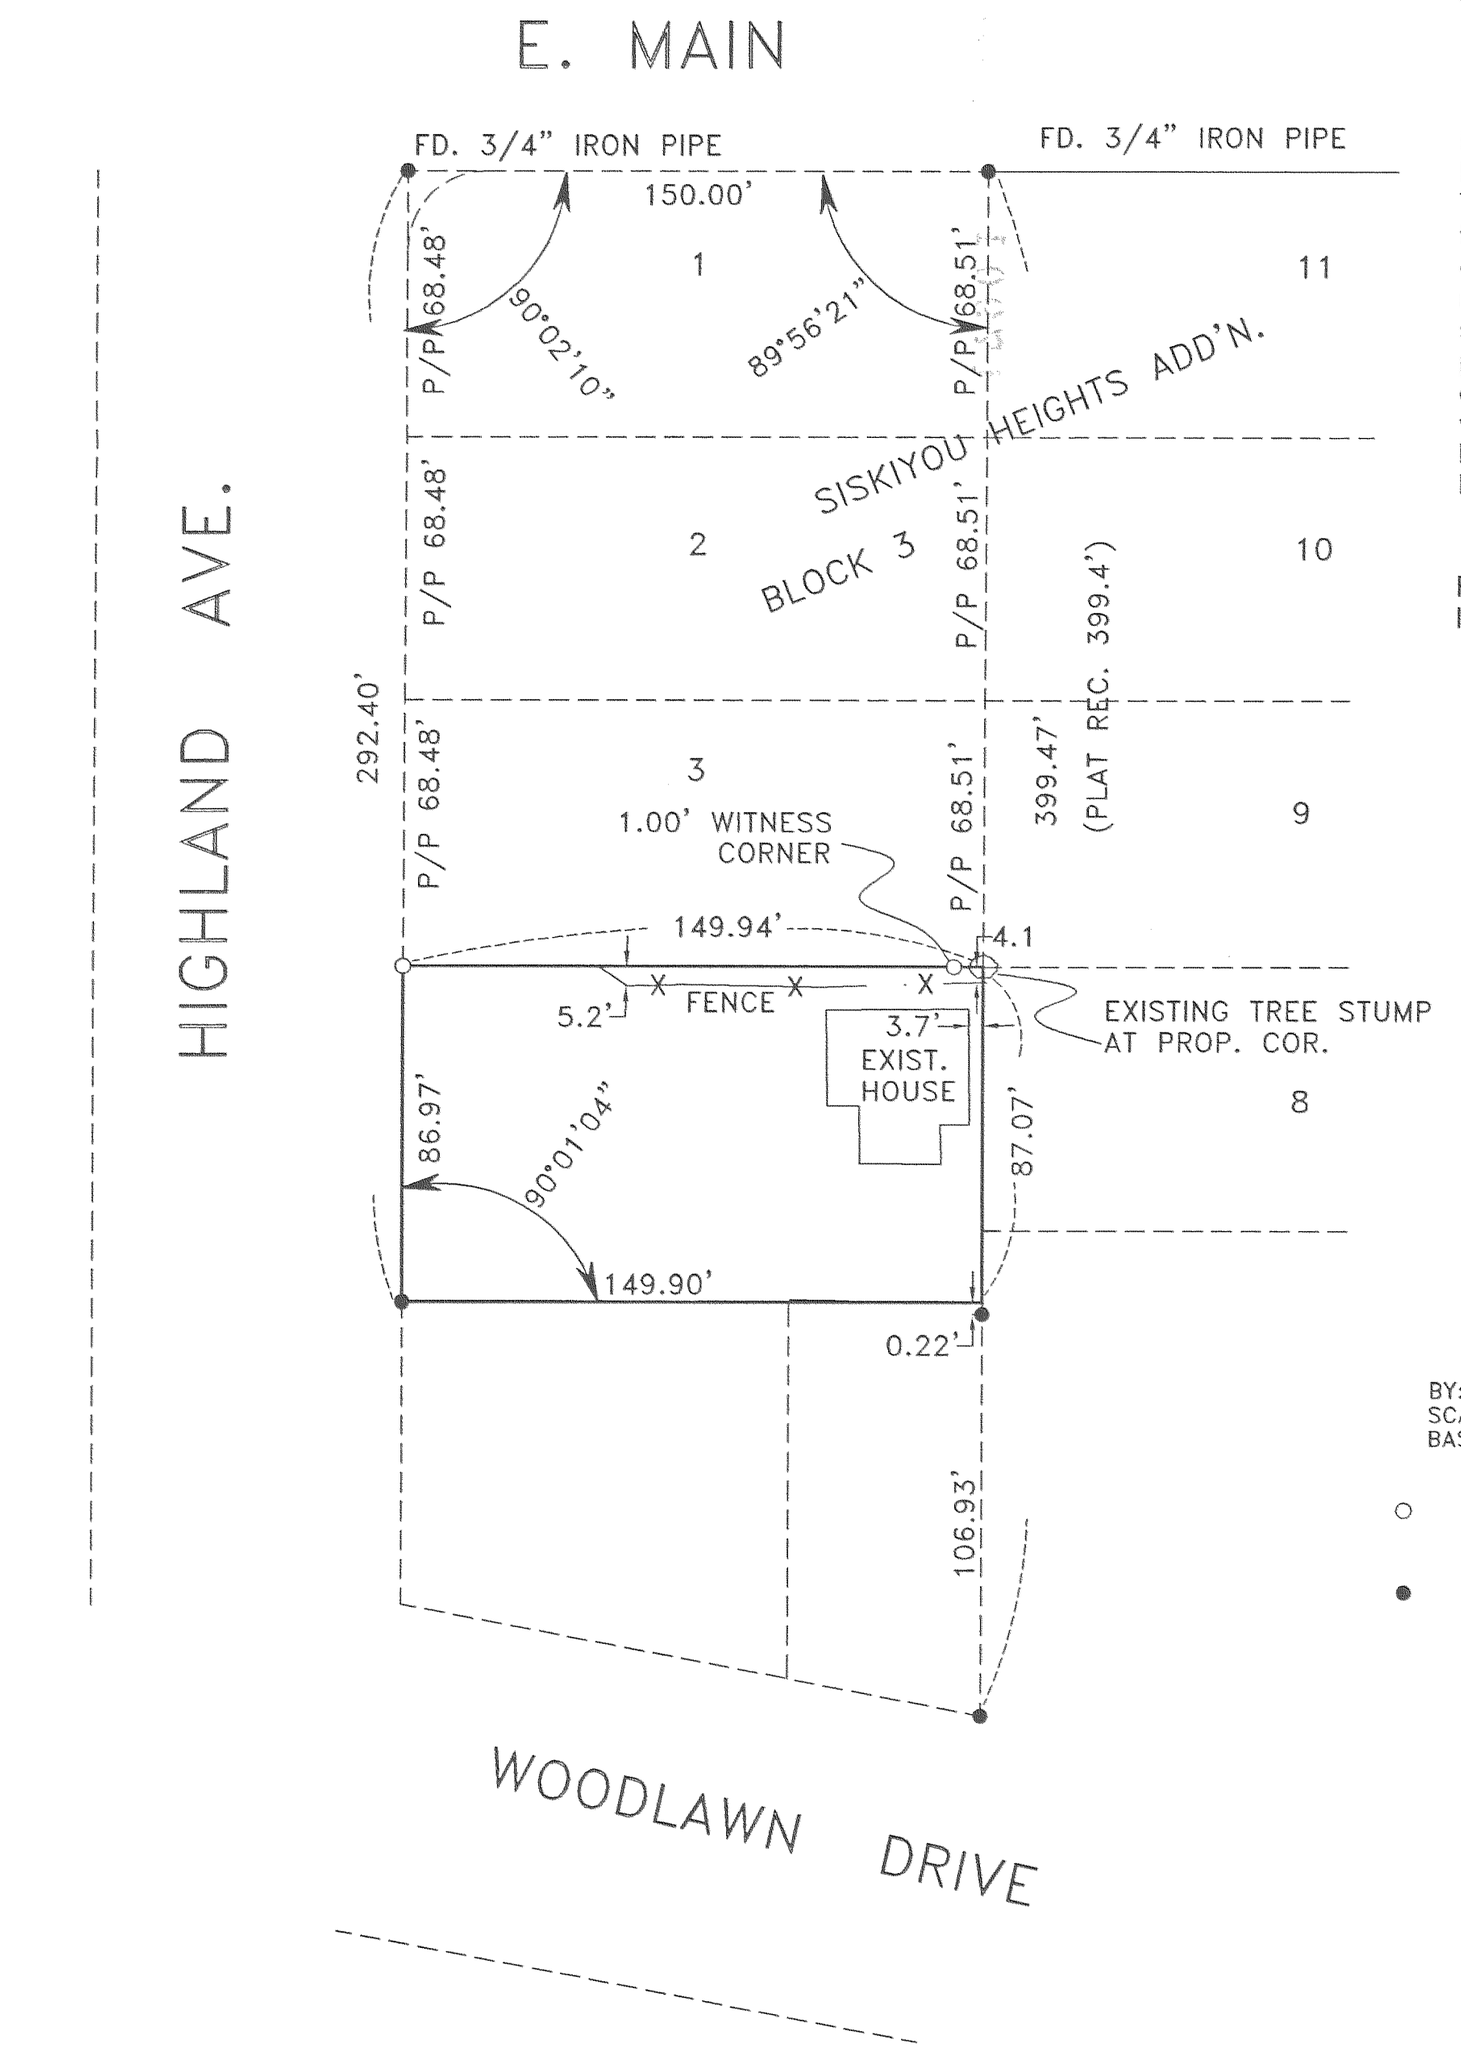

SURVEY NARRATIVE TO COMPLY WITH PARAGRAPH 209.250
OREGON REVISED STATUTES

PURPOSE: to survey and monument that tract of land described in Deed Document No. 02-55792 of the official records of Jackson County, Oregon

PROCEDURE:
The south boundary of the subject tract has been previously surveyed and monumented by L. N. Dow, per filed survey No. 955. Utilizing a Leica TCA 1800 total station, a control traverse was run tying found monuments per Siskiyou Heights Add'n. and filed survey No. 955. The monument found near the southeast corner of property now being surveyed appears to be out of position by 0.22'; possibly due to fence line construction. The location of the other found monuments fit quite favorably with Siskiyou Heights Addition plat record. The location of the north property line was determined by proportion utilizing existing monumentation.

Field angles observed or computed are shown in lieu of bearings.

HOFFBUHR & ASSOCIATES, INC.
3155 ALAMEDA STREET, SUITE 201
MEDFORD, OREGON 97504
(541)779-4641

BY: DARRELL L. HUCK PLS No. 2023
SCALE: 1 inch = 40' AUGUST 26, 2003
BASIS OF BEARING: SURVEY NO. 955

○ = Set 5/8"x24" iron reinforcing pin with plastic cap stamped "D. Huck LS 2023".

● = Found 5/8" iron pin per Survey No. 955, unless noted otherwise

REGISTERED
PROFESSIONAL
LAND SURVEYOR

Darrell L Huck

OREGON
FEBRUARY 4, 1983
DARRELL L. HUCK
2023

Expires 6/30/2005

37 1W 29BC, T.L. 2500

(02313wk.dwg)