

R. 1 W.
R. 1 E.

S. 1/2 OF S.W. 1/4 SEC. 30

ELK CREEK ROAD





SEC. COR.
(FOUND)
25 30
36 31

S1/4 SEC. 30, T.33S., R.1E., W.M.
N1/4 SEC. 31, T.33S., R.1E., W.M.

581°39'30"E 798.26'

1/4 SEC. COR.
(FOUND)

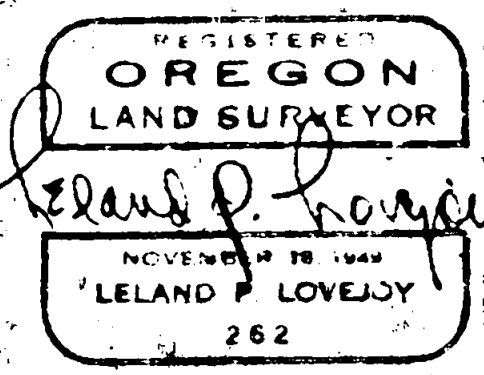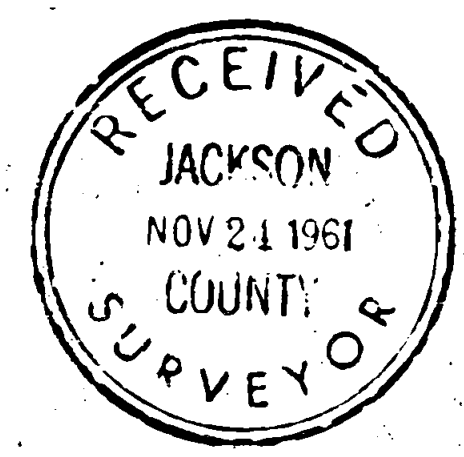

REC. POS. OF WILLAMETTE MERIDIAN

153.86'
L=100.12'
R=140.22'

L=589°20'30"W 99.07'

911°03'31" AT
900°50'00" AT
172°39'00" W 158.00'
(REC. 17°25'14")
900°00'00" AT

N. 1/2 OF N.W. 1/4 SEC. 31

HIGHWAY NO. 66

REC. POS. OF E-W 1/4 LINE

BOUNDARY SURVEY OF PROPERTY
SITUATE IN
S. 1/2 OF S.W. 1/4 SEC. 30 AND N. 1/2 OF N.W. 1/4
SEC. 31, ALL IN T.33S., R.1E., W.M.
JACKSON COUNTY OREGON
FOR
D.H. DAVIS
L.P. LOVEJOY L.S. MEDFORD, ORE.
SCALE: 1"=200' 11-19-1961
BEARINGS PER COUNTY ROAD RECORDS
O = SET 1/2" STEEL PIN

Survey Narrative to Comply with Section 87-3301947 Oregon State Laws




Survey for: D. H. Davis
Elk Creek Road, near
Junction Oregon State Highway No. 62
Trail, Oregon

Purpose of Survey: To establish property corners.

Survey Location: S 1/2 of SW 1/4, Sec. 30, and N 1/2
of NW 1/4, Sec. 31, T. 33 S., R. 1 E.,
W. M., Jackson County, Oregon.

Survey Procedure: Found section corner, quarter corner,
Road and other survey points and used
as basis for survey control. Set 5/8"
steel pins as shown on map.

Leland P. Lovejoy
Registered Land Surveyor
Work completed November 14, 1961

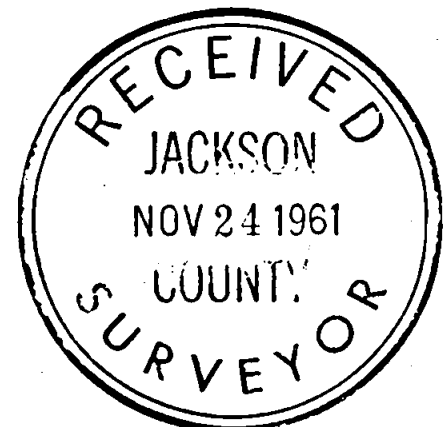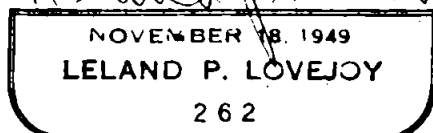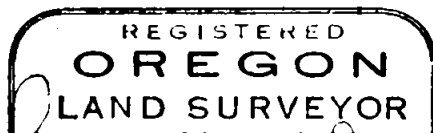

P. 1 W.
R. 1 E.

S. 1/2 OF S.W. 1/4 SEC. 30

CREEK ROAD

SEC. COR.
(POUND)
25 30
36 31


84°08'30"E 258.50'

S85°41'00"E 30.00'

S41 SEC. 30, T.33S, R.1E., W.M.
NE SEC. 31, E.33S, R.1E., W.M.

S87°31'00"E 700.26'

SEC. COR.
(POUND)

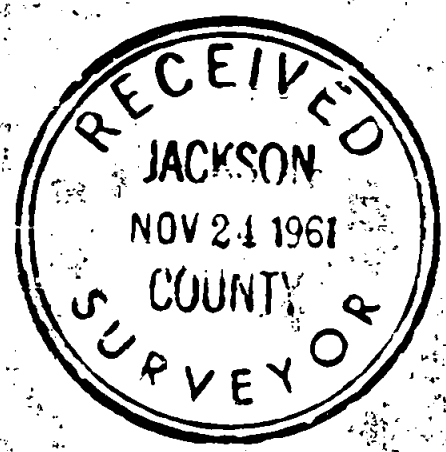

REC. POS. OF WILLAMETTE MERIDIAN

7207'10"E 153.88'
L. 589'25'30"W 30.00'
990'-56.0' N.E.
7725'10"W 150.00'
SEC. 17/225' N

N. 1/2 OF N.W. 1/4 SEC. 31

CENTER LINE

NEW WAY

REC. POS. OF E-W LINE

BOUNDARY SURVEY OF PROPERTY
SITUATE IN
S. 1/2 OF S.W. 1/4 SEC. 30 AND N. 1/2 OF N.W. 1/4
SEC. 31, ALL IN T.33S, R.1E., W.M.
JACKSON COUNTY OREGON
FOR
D.H. DAVIS
SCALE: 1"=200' 11-14-1961
BEARINGS PER COUNTY ROAD RECORDS
● = SET 1/2" STEEL PIN