

OREGON CORNER RESTORATION FORM

Section 34 Township 34S Range 2E
County JACKSON Date 1/26/04

Corner Designation

T34S R2E SECTION 34
CE 1/16

- Condition Report Only
- Not Found
- Renewed
- Unrecorded
- Surveyed In
- Referenced Out

Previous Renewals/Surveys, etc. 1985 RAMBO SURVEY 10333



Monument(s) & Accessories Found: (Condition and Source)

14" OAK BEARS S73°E 14⁰ FT. (RECORD S72°52'E 14⁰ FT) HEADED FACE
AND TAG
MADROWE BT AT RECORD S32°05'W 15¹ FT. IS NOW UPROOTED AND DOWN

Monument Detail

Sketch

1 1/2" ALUMINUM CAP.

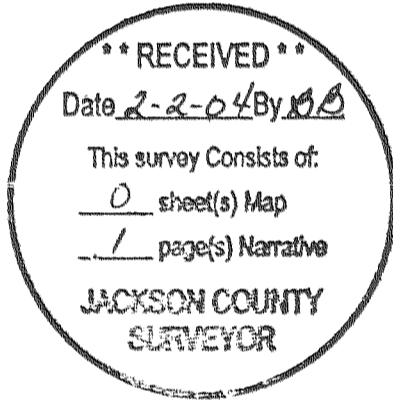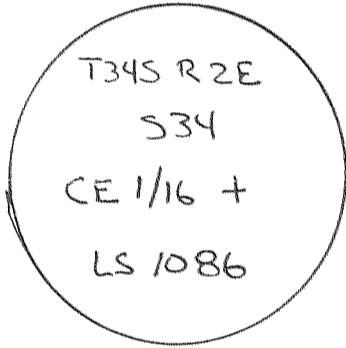

Monument Set (Procedures and Description)

New Accessories

13" DOUGLAS FIR BEARS S32°W 28° FT. WE SCRIBE CE 1/16 S34 BT AND
TAG TREE

Location & Comments

Surveyor's Seal

CORNER LIES ON STEEP
WEST FACING SLOPE ON
ROCKY RIDGELINE. WE
BLAZE AND PAINT NORTH
AND WEST FROM CORNER.

Compass Declination 19 1/2°
Firm/Agency LOWE ROCK
TIMBER COMPANY
Address P.O. BOX 1127
ROSEBURG, ORE 97470
Party Chief KEN HOFFINE
Notes KEN HOFFINE
Witness PAT CARTER

