

OREGON CORNER RESTORATION FORM

Section 13 Township 34S Range 3E

County JACKSON Date 1/27/04

Corner Designation

T 34S R 3E Sec. 13

CW 1/16

- Condition Report Only
- Not Found
- Renewed
- Unrecorded
- Surveyed In
- Referenced Out


Previous Renewals/Surveys, etc. BLM ADMINISTRATIVE SURVEY

Monument(s) & Accessories Found: (Condition and Source)

36" CEDAR STUMP BEARS N18 1/2° W 6.5 FT. RECORD N18 3/4° W 6.3 FT.
DOUGLAS FIE RECORD S13° E 14.8 FT. IS NOW UPROOTED AND DOWN

Monument Detail

5/8" IRON ROD

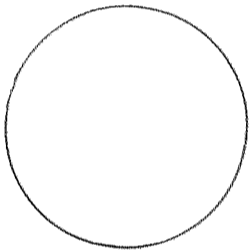


0.5 FT. ABOVE GROUND

Monument Set (Procedures and Description)

Sketch

LRT BEARINGS AND DISTANCES FROM LRT SURVEY BETWEEN CORNERS FOR LINE BLAZING

() REFERENCES BLM ADMINISTRATIVE SURVEY FILED IN JACKSON COUNTY

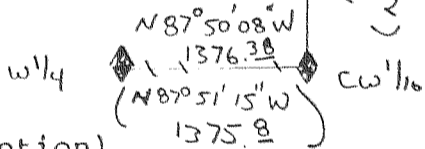

New Accessories

12" DOUGLAS FIE BEARS S7° E 28.9 FT W/ SCRIBE CW 1/16 S13 BT AND TAG TREE

Location & Comments

CORNER LIES ON EAST
FACING SLOPE IN SWAG
AREA WITH LOTS OF DOWN
SWAGS. WE BLAZE AND
PAINT WEST AND NORTH
FROM CORNER.

Compass Declination 19 1/2
Firm/Agency LOWE ROCK
TIMBER COMPANY
Address P.O. BOX 1127
ROSEBURG, OR 97470
Party Chief KEN HOFFINE
Notes GARY ANGIOLET
Witness PAT CARTER

Surveyor's Seal

REGISTERED PROFESSIONAL LAND SURVEYOR

Ken W Hoffine
OREGON
JULY 18, 1987
KEN W. HOFFINE
2291

MSB
s of:
p
ative
NTY