




# POST MONUMENTATION MAP FOR ISH RANCH ESTATES

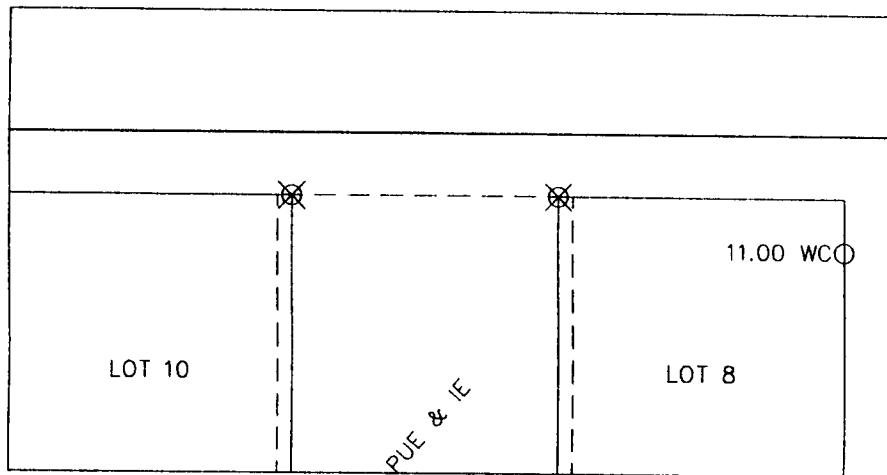


**SURVEY FOR:**

MEL SHERBOURNE  
3237 CARRIAGE DRIVE  
MEDFORD, OR 97501

**SURVEY BY:**

L.J. Friar & Associates, P.C.  
Consulting Land Surveyors  
816 West Eighth Street  
Medford, OR 97501  
(541) 772-2782  
ljfriar@charter.net

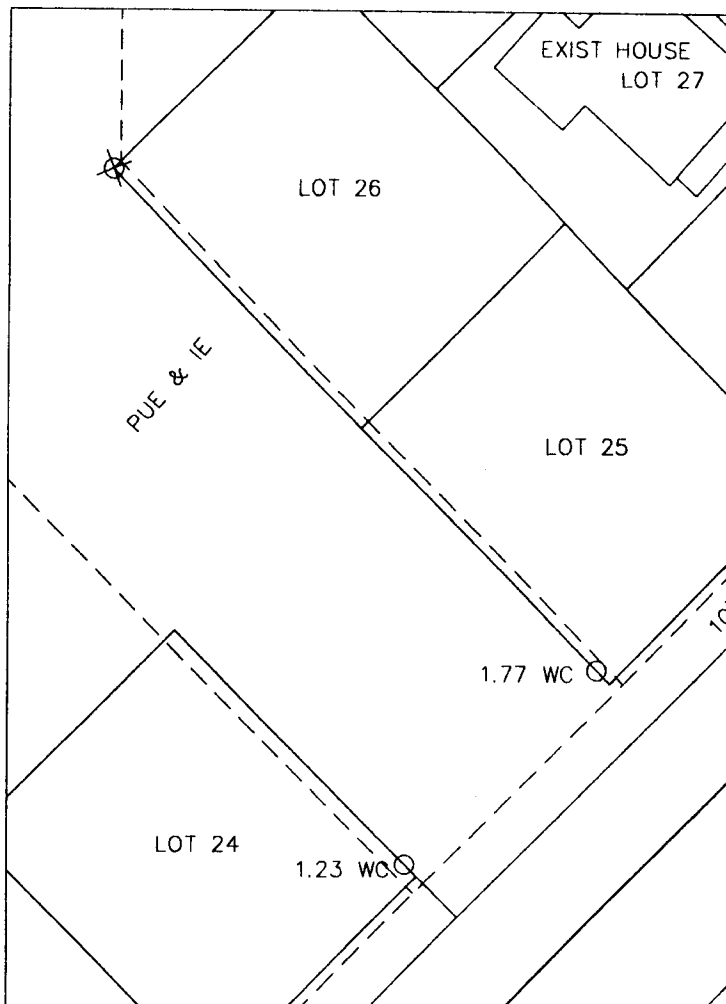

LEGEND

- ⊗ = SET BRASS TAG MKD. L.J. & ASSOC. IN LEAD PLUG IN CONCRETE.
- = SET 5/8" X 24" IRON PIN W/ PLASTIC CAP MKD. L.J. & ASSOC.
- WC = WITNESS CORNER MONUMENT.

