MAP OF SURVEY


LOCATED IN THE NORTH HALF
OF SECTION 17, TOWNSHIP 34 SOUTH,
RANGE 3 EAST, WILLAMETTE MERIDIAN,
JACKSON COUNTY, OREGON

PURPOSE:

TO SURVEY, MARK, AND POST THE NORTH LINE OF SECTION 17, AS SHOWN ON THIS PLAT.

PROCEDURE:

A SEARCH OF RECORDS REVEALED THAT THE NORTHEAST, NORTHWEST, AND NORTH ONE-QUARTER SECTION CORNERS OF SECTION 17 HAD BEEN REMONUMENTED BY THE BUREAU OF LAND MANAGEMENT FROM ORIGINAL EVIDENCE. A TRAVERSE WAS RUN TYING TO THESE CORNERS, THEN TRUE LINE WAS SURVEYED, MARKED WITH RED PAINTED BLAZES, ORANGE AND BLUE FLAGGING, AND POSTED WITH STEEL POSTS.

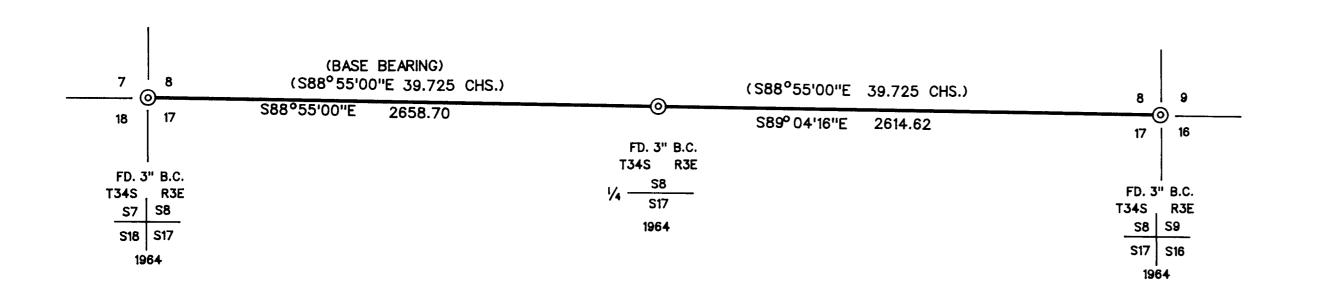

This survey Consists at

______ sheet(s) Map
______ page(s) Narrative

JACKSON COUNTY
SURVEYOR

SURVEY FOR

SWANSON GROUP, INC. P.O. BOX 250 GLENDALE, OREGON 97442

LEGEND

- () RECORD DATA G.L.O. PLAT

LINE MARKED AND POSTED THIS SURVEY

BASIS OF BEARING

G.L.O. PLAT

SCALE

DATE

1" - 500' JULY 3, 2004

SURVEY BY

RAMBO SURVEYING ARTHUR R. RAMBO 735 VISTA PARK DRIVE EAGLE POINT, OREGON 97524



EXPIRES DECEMBER 31, 2004