


T. 36 S. R. 4 W., W.M., JACKSON COUNTY OREGON DEPENDENT RESURVEY AND SUBDIVISION OF SECTIONS 8, 17, & 18

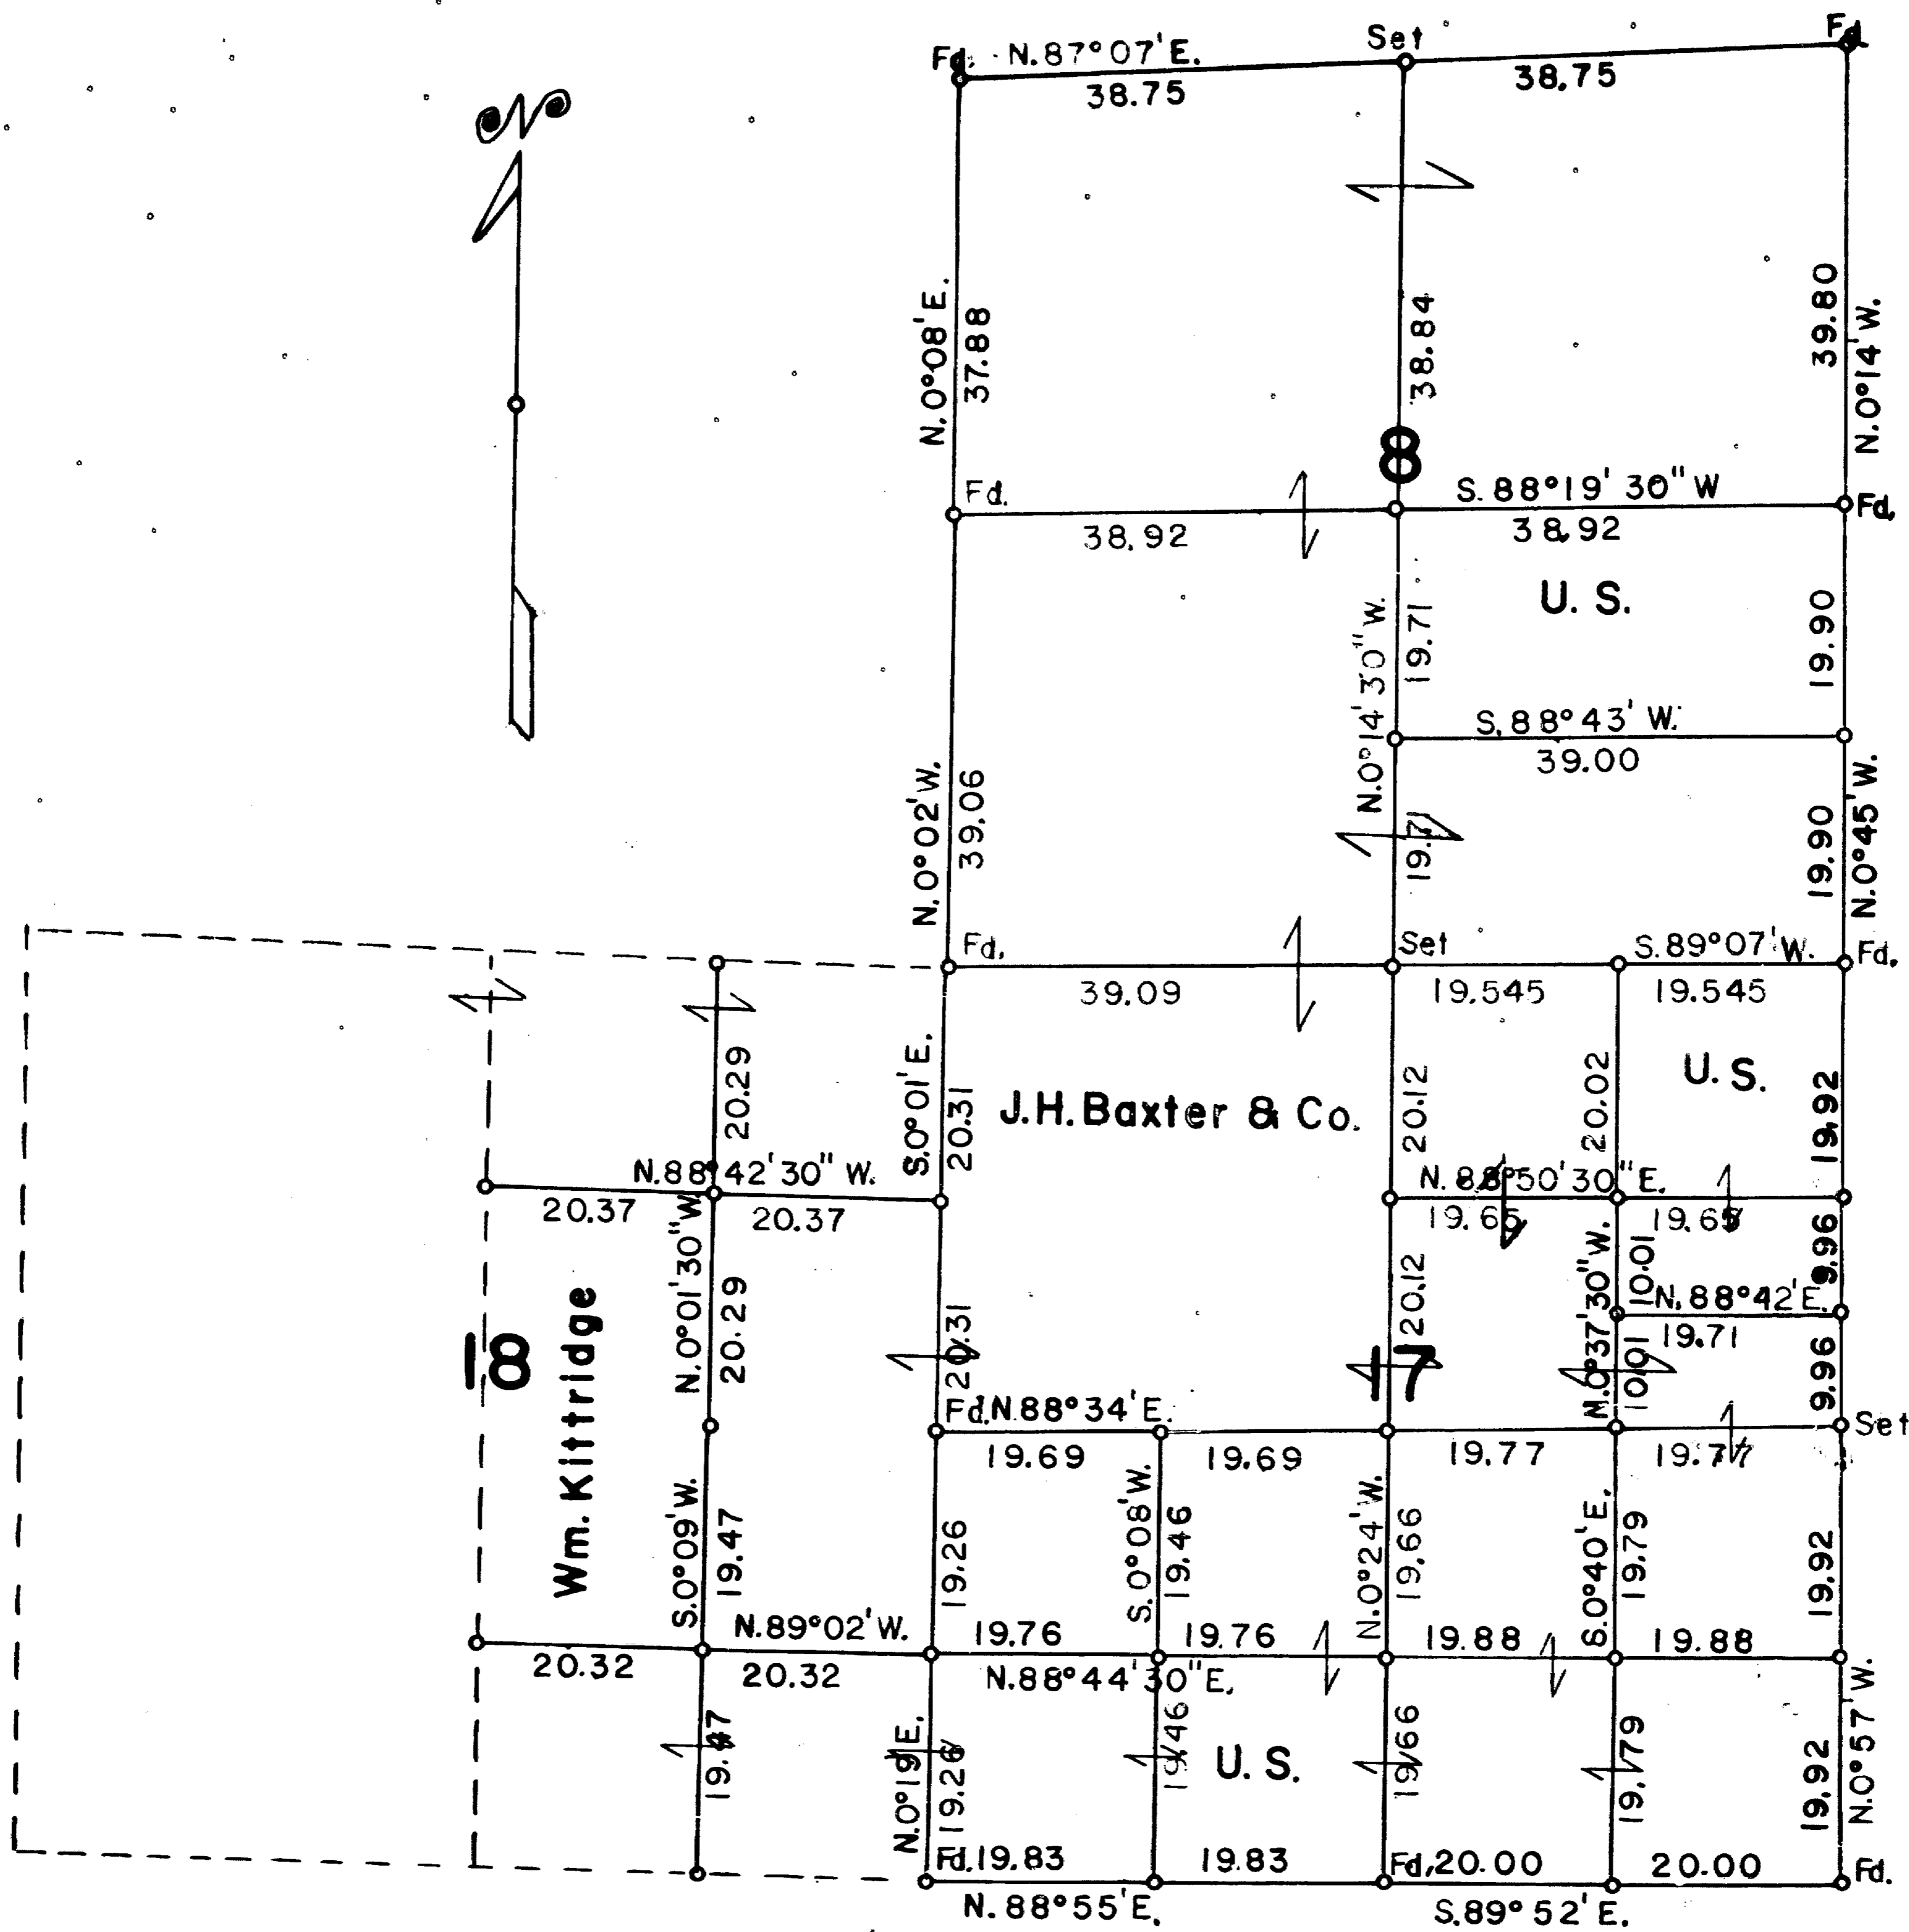

Scale: 1 inch = 20 chains = 1320 feet


Mean Magnetic Declination 20° 10' East

The bearings of all lines are referred to the true meridian determined by solar observations
o = Corner Occupied and Monumented

— Lines Surveyed - - - - - Lines Not Retraced

Survey executed May 8 to November 24, 1961

I hereby certify that the survey represented by this plat is executed in conformity with the laws of the State of Oregon.

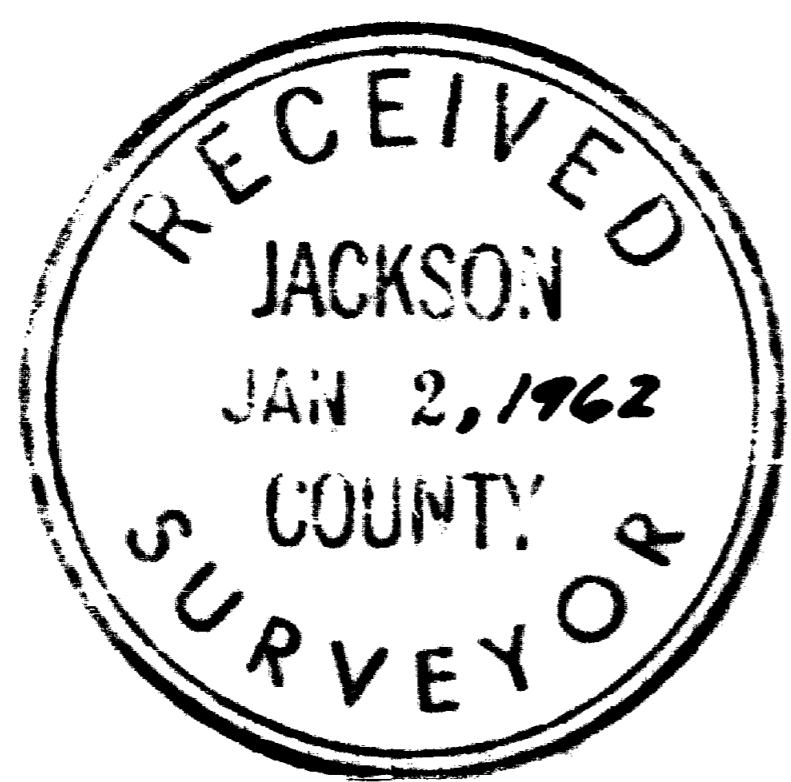

Marvin C. Ramsey

T. 36 S., R. 4 W.

Chains

A madrona 20 ins. in diam., bears N. 20° W., 56 lks.
dist., down, burned and decayed.

Set an iron pipe 3 ft. long $1\frac{1}{2}$ ins. in diam., 28 ins. in
the ground, mkd. RS404, from which a new bearing tree

A Douglas fir 16 ins. in diam., bears S. 29 $\frac{1}{2}$ ° W., 48 lks.
dist., mkd. $\frac{1}{2}$ S8 RS404 BT.

S. 0° 45' E., bet. secs. 8 and 9, taking new measurement.

19.90 Point for the South 1/16 sec. cor. at proportionate distance.

Set an iron pipe 3 ft. long 1 in. in diam., 28 ins. in
the ground, mkd. RS404, from which

A madrona 8 ins. in diam., bears S. 67° E., 11 lks.
dist., mkd. S 1/16 S9 RS404 BT.

A madrona 8 ins. in diam., bears N. 11 $\frac{1}{2}$ ° W., 20 lks.
dist., mkd. S 1/16 S8 RS404 BT.

39.80 To the sec. cor. of secs. 8, 9, 16 and 17.

Thence

N. 0° 14' 30" W., on the North and South center line
of section 8.

19.71 Point for the center South 1/16 sec. cor. at proportionate
distance.

Set an iron pipe 3 ft. long 1 in. in diam., 28 ins. in
the ground, mkd. RS404, from which

A black oak 6 ins. in diam., bears S. 2° E., 7 lks.
dist., mkd. CS 1/16 S8 RS404 BT.

A madrona 8 ins. in diam., bears N. 51° E., 93 lks.
dist., mkd. CS 1/16 S8 RS404 BT.

39.42 Point for the center $\frac{1}{4}$ sec. cor. at the intersection
of the East and West center line

Set an iron pipe 3 ft. long 1 in. in diam., 28 ins. in
the ground, mkd. RS404, from which


A black oak 24 ins. in diam., bears N. 53° E., 57 lks.
dist., mkd. C $\frac{1}{4}$ S8 RS404 BT.

A black oak 6 ins. in diam., bears S. 21° E., 30 lks.
dist., mkd. C $\frac{1}{4}$ S8 RS404 BT.

A black oak 6 ins. in diam., bears S. 33 $\frac{1}{2}$ ° W., 17 lks.
dist., mkd. C $\frac{1}{4}$ S8 RS404 BT.

A black oak 14 ins. in diam., bears N. 40 $\frac{1}{4}$ ° W., 75 lks.
dist., mkd. C $\frac{1}{2}$ S8 RS404 BT

I hereby certify that the bearings of all lines recorded
in this survey were determined by solar observations
and that the survey described in the foregoing field
notes was executed in conformity with the laws of the
State of Oregon.

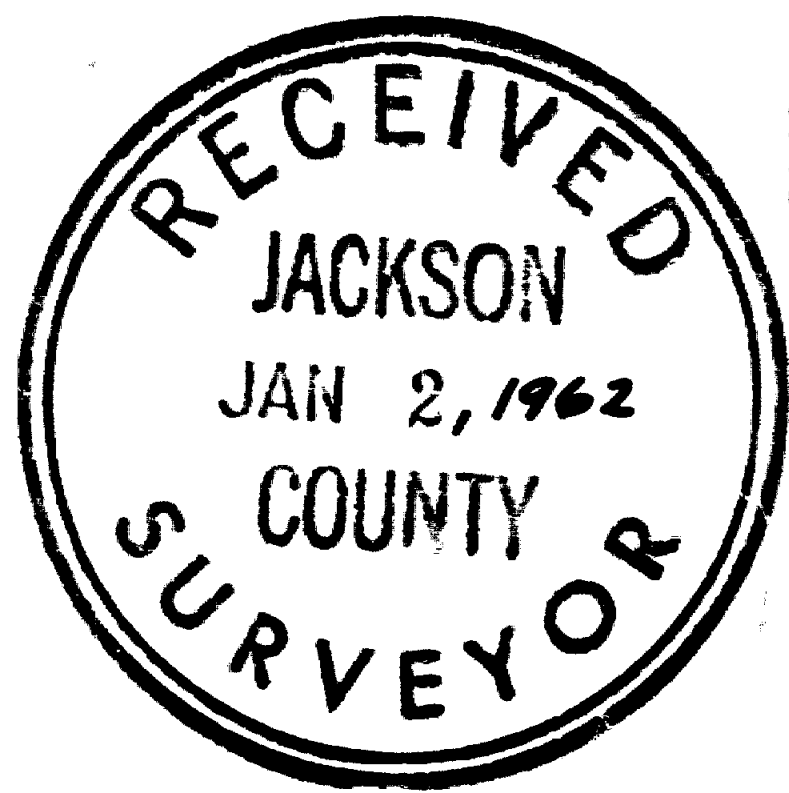

Marvin C. Ramsey

T. 36 S., R. 4 W.

Chains

- A Douglas fir sawed stump 28 ins. in diam., bears S. $71\frac{1}{2}^{\circ}$ W., 59 lks. dist., healed. I open and find mks. BT.
- Set an iron pipe 3 ft. long 2 ins. in diam., 15 ins. in the ground to bedrock, mkd. RS404, from which new bearing trees
- A Douglas fir 14 ins. in diam., bears N. 67° E., 52 lks. dist., mkd. T36S R4W S5 RS404 BT.
- A live oak 4 ins. in diam., bears S. 33° E., 26 lks. dist., mkd. T36S R4W S8 RS404 BT.
- A madrona 8 ins. in diam., bears S. 26° W., 31 lks. dist., mkd. T36S R4W S7 RS404 BT.
- A live oak 6 ins. in diam., bears N. $87\frac{1}{2}^{\circ}$ W., 46 lks. dist., mkd. T36S R4W S6 RS404 BT.
- N. $87^{\circ} 07'$ E., on true line bet. sec. 5 and 8.
- 38.75 Point for the $\frac{1}{4}$ sec. cor. at proportionate distance; fail to find any evidence of the original corner.
- Set an iron pipe 3 ft. long $1\frac{1}{2}$ ins. in diam., 28 ins. in the ground, mkd. RS404, from which
- A Douglas fir 14 ins. in diam., bears S. 59° W., 33 lks. dist., mkd. $\frac{1}{4}$ S8 RS404 BT.
- A Douglas fir 14 ins. in diam., bears N. 73° W., $44\frac{1}{2}$ lks. dist., mkd. $\frac{1}{4}$ S5 RS404 BT.
- 77.50 To the sec. cor. of secs. 4, 5, 8 and 9 determined from the only two extant original bearing trees
- A sugar pine sawed stump 26 ins. in diam., bears N. 70° E., 88 lks. dist., mkd. BT.
- A black oak 18 ins. in diam., bears S. 15° W., 101 lks. dist., healed and dead.
- Set an iron pipe 3 ft. long 2 ins. in diam., 28 ins. in the ground, mkd. RS404 from which new bearing trees
- A Douglas fir 6 ins. in diam., bears N. $43\frac{1}{4}^{\circ}$ E., 72 lks. dist., mkd. T36S R4W S4 RS404 BT.
- A Douglas fir 16 ins. in diam., bears S. 51° E., 85 lks. dist., mkd. T36S R4W S9 RS404 BT.
- A yellow pine 10 ins. in diam., bears S. 67° W., 129 lks. dist., mkd. T36S R4W S8 RS404 BT.
- A black oak 8 ins. in diam., bears N. $15\frac{1}{2}^{\circ}$ W., 94 lks. dist., mkd. T36S R4W S5 RS404 BT.
- S. $0^{\circ} 14'$ E., on true line bet. secs. 8 and 9.
- 39.80 I find a decayed post in a mound of stone from which the original bearing trees
- A yellow pine 36 ins. in diam., bears S. 17° E., 110 lks. dist., with axe face in top blaze, mks. burned out and partial scribe mks. in bottom blaze. I remark $\frac{1}{4}$ S9 RS404 BT.

T. 36 S., R. 4 W.

Chains

A madrona 8 ins. in diam., bears S. 52° W., 16 lks.
dist., mkd. SE NE $\frac{1}{64}$ S17 RS404 BT.

40.04 To the center East $\frac{1}{16}$ sec. cor.

Thence

S. 0° 40' E., on the North and South center line of the
Southeast $\frac{1}{4}$ of sec. 17

19.79 Point for the Southeast $\frac{1}{16}$ sec. cor. at the intersection
of the East and West center line of the Southeast $\frac{1}{4}$.

Set an iron pipe 3 ft. long 1 in. in diam., 28 ins. in
the ground, mkd. RS404, from which

A madrona 10 ins. in diam., bears N. 71° W., 12 lks.
dist., mkd. SE $\frac{1}{16}$ S17 RS404 BT.

A madrona 8 ins. in diam., bears N. $29\frac{1}{2}^{\circ}$ E., 34 lks.
dist., mkd. SE $\frac{1}{16}$ S17 RS404 BT.

39.58 To the East $\frac{1}{16}$ sec. cor. of secs. 17 and 20.

Thence

N. 0° 08' E., on the North and South center line of the
Southwest $\frac{1}{4}$ of sec. 17.

19.46 Point for the Southwest $\frac{1}{16}$ sec. cor. at the intersection
of the East and West center line of the Southwest $\frac{1}{4}$.

Set an iron pipe 3 ft. long 1 in. in diam., 28 ins. in
the ground, mkd. RS404, from which

A black oak 12 ins. in diam., bears S. 66° E., 17 lks.
dist., mkd. SW $\frac{1}{16}$ S17 RS404 BT.

A Douglas fir 20 ins. in diam., bears S. $12\frac{1}{2}^{\circ}$ W., 31 lks.
dist., mkd. SW $\frac{1}{16}$ S17 RS404 BT.

38.92 To the center West $\frac{1}{16}$ sec. cor. of sec. 17.

N. 0° 02' W., on true line bet. secs. 7 and 8.

39.06 To the $\frac{1}{4}$ sec. cor. determined from the only extant original
bearing tree

A Douglas fir sawed stump 30 ins. in diam., bears N. 20° E.,
20 lks. dist., healed. I open and find mks. BT.

Set an iron pipe 3 ft. long $1\frac{1}{2}$ ins. in diam., 28 ins. in
the ground, mkd. RS404, from which new bearing trees

A Douglas fir 14 ins. in diam., bears S. 34° E., 78 lks.
dist., mkd. $\frac{1}{4}$ S8RS404 BT.

A Douglas fir 40 ins. in diam., bears N. 79° W., 37 lks.
dist., mkd. $\frac{1}{4}$ S7 RS404 BT.

N. 0° 08' E., taking new measurement.

37.88 To the sec. cor. of secs. 5, 6, 7 and 8 determined from
the only extant original bearing tree

Chains

59.15 Point for East 1/16 sec. cor.

Set an iron pipe 3 ft. long 1 in. in diam., 28 ins. in the ground, mkd. RS404, from which

A black oak 6 ins. in diam., bears S. 86° E., 47 lks. dist., mkd. CE 1/16 S17 RS404 BT.

A black oak 18 ins. in diam., bears N. 15½° W., 39 lks. dist., mkd. CE 1/16 S17 RS404 BT.

78.92 To the 1/4 sec. cor. of secs. 16 and 17.

Thence

N. 0° 24' W., on the North and South center line of sec. 17.

19.66 Point for the center South 1/16 sec. cor.

Set an iron pipe 3 ft. long 1 in. in diam., 28 ins. in the ground, mkd. RS404, from which

A sugar pine 20 ins. in diam., bears N. 82½° E., 22 lks. dist., mkd. CS 1/16 S17 RS404 BT.

A Douglas fir 22 ins. in diam., bears S. 84° E., 44 lks. dist., mkd. CS 1/16 S17 RS404 BT.

39.32 To the center 1/4 sec. cor. of sec. 17.

59.44 Point for the center North 1/16 sec. cor.

Set an iron pipe 3 ft. long 1 in. in diam., 28 ins. in the ground, mkd. RS404, from which

A cedar 18 ins. in diam., bears S. 18° W., 25 lks. dist., mkd. CN 1/16 S17 RS404 BT.

A yellow pine 20 ins. in diam., bears N. 29° W., 32 lks. dist., mkd. CN 1/16 S17 RS 404 BT.

79.56 To the 1/4 sec. cor of secs. 8 and 17.

Thence

S. 0° 37' 30" E., on the North and South center line of the Northeast 1/4 of sec. 17.

20.02 Point for the Northeast 1/16 sec. cor. at the intersection of the East and West center line of the Northeast 1/4.

Set an iron pipe 3 ft. long 1 in. in diam., 28 ins. in the ground, mkd. RS404, from which

A Douglas fir 3 ins. in diam., bears S. 22½° E., 10 lks. dist., mkd. NE 1/16 S17 RS404 BT.

A sugar pine 22 ins. in diam., bears S. 55½° W., 60 lks. dist., mkd. NE 1/16 S17 RS404 BT.

30.03 Point for 1/64 sec. cor. at proportionate distance.

Set an iron pipe 3 ft. long 1 in. in diam., 28 ins. in the ground, mkd. RS404, from which

A madrona 8 ins. in diam., bears N. 2½° E., 23½ lks. dist., mkd. SE NE 1/64 S17 RS404 BT.

T. 36 S., R. 4 W.

Chains

A sugar pine 10 ins. in diam., bears N. $58\frac{1}{2}^{\circ}$ E., 33 lks.
dist., mkd. T36S R4W S9 RS404 BT.

A Douglas fir 20 ins. in diam., bears S. $81\frac{1}{2}^{\circ}$ E., 27 lks.
dist., mkd. T36S R4W S16 RS404 BT.

A Douglas fir 16 ins. in diam., bears N. $27\frac{1}{2}^{\circ}$ W., 9 lks.
dist., mkd. T36S R4W S8 RS404 BT.

S. 89° 07' W., on true line bet. secs. 8 and 17.

19.545 Point for East $\frac{1}{16}$ sec. cor. at proportionate distance.

Set an iron pipe 3 ft. long 1 in. in diam., 28 ins. in the
ground, mkd. RS404, from which

A yellow pine 16 ins. in diam., bears N. 87° E., 38 lks.
dist., mkd. E $\frac{1}{16}$ S8 RS404 BT.

A madrona 8 ins. in diam., bears S. 27° E., 10 lks.
dist., mkd. E $\frac{1}{16}$ S17 RS404 BT.

39.09 Point for the $\frac{1}{4}$ sec. cor. at proportionate distance;
fail to find any evidence of the original corner.

Set an iron pipe 3 ft. long $1\frac{1}{2}$ ins. in diam., 28 ins.
in the ground, mkd. RS404, from which

A Douglas fir 18 ins. in diam., bears S. $67\frac{1}{4}^{\circ}$ E., 66 lks.
dist., mkd. $\frac{1}{4}$ S17RS404 BT.

A black oak 8 ins. in diam., bears N. $28\frac{3}{4}^{\circ}$ W., 65 lks.
dist., mkd. $\frac{1}{4}$ S8 RS404 BT.

78.18 To the sec. cor. of secs. 7, 8, 17 and 18.

Thence

N. 88° 44' E., on East and West center line of sec. 17.

19.69 Point for the center West $\frac{1}{16}$ sec. cor.

Set an iron pipe 3 ft. long 1 in. in diam., 28 ins. in
the ground, mkd. RS404, from which

A Douglas fir 12 ins. in diam., bears S. $21\frac{3}{4}^{\circ}$ E., 51 lks.
dist., mkd. CW $\frac{1}{16}$ S17 RS404 BT.

A cedar 20 ins. in diam., bears N. 84° W., 10 lks.
dist., mkd. CW $\frac{1}{16}$ S17 RS404 BT.

39.38 Point for the center $\frac{1}{4}$ sec. cor. at the intersection of
the North and South center line.

Set an iron pipe 3 ft. long $1\frac{1}{2}$ ins. in diam., 28 ins. in
the ground, mkd. RS404, from which

A madrona 10 ins. in diam., bears N. 85° E., 85 lks.
dist., mkd. C $\frac{1}{4}$ S17 RS404 BT.

A Douglas fir 14 ins. in diam., bears S. 70° E., 53 lks.
dist., mkd. C $\frac{1}{4}$ S17 RS404 BT.

A Douglas fir 6 ins. in diam., bears S. $35\frac{1}{2}^{\circ}$ W., 51 lks.
dist., mkd. C $\frac{1}{4}$ S17 RS404 BT.

A Douglas fir 26 ins. in diam., bears N. 79° W., 65 lks.
dist., mkd. C $\frac{1}{2}$ S17 RS404 BT.

T. 36 S., R. 4 W.

Chains

A madrona 8 ins. in diam., bears S. 68° W., 25 lks.
dist., mkd. T36S R4W S20 R5404 BT.

A white oak 5 ins. in diam., bears N. 71° W., 12 lks.
dist., mkd. T36S R4W S17 R5404 BT.

N. 0° 57' W., bet. secs. 16 and 17.

19.92 Point for South $1/16$ sec. cor. at proportionate distance.

Set an iron pipe 3 ft. long 1 in. in diam., 28 ins. in
the ground, mkd. R5404, from which

A Douglas fir 8 ins. in diam., bears S. 26° E., 67 lks.
dist., mkd. S $1/16$ S16 R5404 BT.

A black oak 6 ins. in diam., bears N. $52\frac{1}{2}^{\circ}$ W., 51 lks.
dist., mkd. S $1/16$ S17 R5404 BT.

39.84 Point for $\frac{1}{4}$ sec. cor. at proportionate distance, fail to
find any evidence of the original corner.

Set an iron pipe 3 ft. long $1\frac{1}{2}$ ins. in diam., 8 ins. in
the ground to bedrock, mkd. R5404, with mound of stone
to top, from which

A white oak 6 ins. in diam., bears S. $35\frac{1}{2}^{\circ}$ E., 45 lks.
dist., mkd. $\frac{1}{4}$ S16 R5404 BT.

A Douglas fir 26 ins. in diam., bears N. 3° W., 28 lks.
dist., mkd. $\frac{1}{4}$ S17 R5404 BT.

49.80 Point for $1/64$ sec. cor. at proportionate distance.

Set an iron pipe 3 ft. long 1 in. in diam., 28 ins. in
the ground, mkd. R5404, from which

A madrona 6 ins. in diam., bears N. 18° E., 34 lks.
dist., mkd. SN $1/64$ S16 R5404 BT.

A yellow pine 16 ins. in diam., bears N. 22° W., 74 lks.
dist., mkd. SN $1/64$ S17 R5404 BT.

59.76 Point for North $1/16$ sec. cor. at proportionate distance.

Set an iron pipe 3 ft. long 1 in. in diam., 26 ins. in
the ground, from which

A black oak 8 ins. in diam., bears East 2 lks. dist.,
mkd. N $1/16$ S 16 R5404 BT.

A Douglas fir 16 ins. in diam., bears N. 2° W., 2 lks.
dist., mkd. N $1/16$ S17 R5404 BT.

79.68 To the sec. cor. of secs. 8, 9, 16 and 17 determined
from the only two extant original bearing trees

A black oak 20 ins. in diam., bears N. 57° D., 53 lks.
dist., down with partial scribe marks.

A black oak 22 ins. in diam., bears S. 63° W., 94 lks.
dist., healed.

Set an iron pipe 3 ft. long 2 ins. in diam., 28 ins. in
the ground, mkd. R5404, from which new bearing trees

T. 36 S., R. 4W.

Chains

- 40.58 To the East $1/16$ sec. cor. of secs. 7 and 18, which is monumented with an iron pipe 1 in. in diam., 22 ins. above the ground, mkd. R $54^{\circ}04'$, with mound of stone to top from which
- A Douglas fir 8 ins. in diam., bears N. 44° W., 17 lks. dist., mkd. E $1/16$ S $7^{\circ}RS404$ BT.
- A Douglas fir 8 ins. in diam., bears S. 43° E., 33 lks. dist., mkd. E $1/16$ S $18^{\circ}RS404$ BT.
-
- N. $88^{\circ} 55'$ E., bet. secs. 17 and 20.
- 19.83 Point for West $1/16$ sec. cor. at proportionate distance.
- Set an iron pipe 3 ft. long 1 in. in diam., 12 ins. in the ground to bedrock, mkd. R $54^{\circ}04'$, with mound of stone to top from which
- A yellow pine 14 ins. in diam., bears N. $60\frac{1}{4}^{\circ}$ E., 60 lks. dist., mkd. W $1/16$ S $17^{\circ}RS404$ BT.
- A yellow pine 32 ins. in diam., bears S. 79° W., 19 lks. dist., mkd. W $1/16$ S $20^{\circ}RS404$ BT.
- 39.66 To the $\frac{1}{4}$ sec. cor. of secs. 17 and 20 determined from the original bearing trees
- A black oak 18 ins. in diam., bears N. 48° E., 36 lks. dist., healed.
- A black oak 20 ins. in diam., bears S. 64° W., 70 lks. dist., healed and dead, I open and find mks. $\frac{1}{4}$ S.
- Set an iron pipe 3 ft. long $1\frac{1}{2}$ ins. in diam., 24 ins. in the ground, mkd. R $54^{\circ}04'$, from which new bearing tree
- A Douglas fir 20 ins. in diam., bears S. 35° E., 11 lks. dist., mkd. $\frac{1}{2}$ S $20^{\circ}RS404$ BT.
- S. $89^{\circ} 52'$ E., bet. secs. 17 and 20, taking new measurement.
- 20.00 Point for East $1/16$ sec. cor. at proportionate distance.
- Set an iron pipe 3 ft. long 1 in. in diam., 28 ins. in the ground, mkd. R $54^{\circ}04'$, from which
- A Douglas fir 6 ins. in diam., bears S. 16° W., 13 lks. dist., mkd. E $1/16$ S $20^{\circ}RS404$ BT.
- A yellow pine 6 ins. in diam., bears N. 56° W., 28 lks. dist., mkd. E. $1/16$ S $17^{\circ}RS404$ BT.
- 40.00 The sec. cor. of secs. 16, 17, 20 and 21 is monumented with an iron pipe 2 ins. in diam., 8 ins. above the ground from which
- A white oak 16 ins. in diam., bears N. 17° E., 228 lks. dist., mkd. CS with bottom blaze healed.
- A white oak 26 ins. in diam., bears S. $34\frac{1}{2}^{\circ}$ E., 174 lks. dist., mkd. CS with bottom blaze healed.

New bearing trees

T. 36 S., R. 4 W.

Chains

- A white oak 20 ins. in diam., bears S. 20° E., 7 lks.
dist., mkd. T36S R4W S20 RS404 BT.
- A white oak 14 ins. in diam., bears S. 79° W., 71 lks.
dist., mkd. T36S R4W S19 RS404 BT.
- A yellow pine 14 ins. in diam., bears N. $16\frac{3}{4}^{\circ}$ W., 111 lks.
dist., mkd. T36S R4W S18 RS404 BT.

The East $\frac{1}{16}$ sec. cor. of secs. 18 and 19 is monumented
with an iron pipe 1 in. in diam., 8 ins. above the
ground, mkd. RS404, from which

- A yellow pine 22 ins. in diam., bears S. 2° W., 170 lks.
dist., mkd. E $\frac{1}{16}$ S19 RS404 BT.
- A madrona 6 ins. in diam., bears N. $42\frac{3}{4}^{\circ}$ E., 87 lks.
dist., mkd. E $\frac{1}{16}$ S18 RS404 BT.

Thence

N. $0^{\circ} 09'$ E., on the North and South center line of the
Southeast $\frac{1}{4}$ of sec. 18.

19.47 Point for the Southeast $\frac{1}{16}$ sec. cor. at the intersection
of the East and West center line of the Southeast $\frac{1}{4}$ of
sec. 18

Set an iron pipe 3 ft. long 1 in. in diam., on solid rock
with a mound of stone to top, mkd. RS404, from which

- A madrona 6 ins. in diam., bears S. $16\frac{3}{4}^{\circ}$ W., 291 lks.
dist., mkd. SE $\frac{1}{16}$ S18 RS404 BT.
- A black oak 6 ins. in diam., bears N. $71\frac{1}{2}^{\circ}$ W., 214 lks.
dist., mkd. SE $\frac{1}{16}$ S18 RS404 BT.

38.94 To the center East $\frac{1}{16}$ sec. cor. which is monumented with
an iron pipe 1 in. in diam., 8 ins. above the ground,
mkd. RS404, from which

- A cedar 12 ins. in diam., bears N. $68\frac{1}{2}^{\circ}$ E., 126 lks.
dist., mkd. CE $\frac{1}{16}$ S18 RS404 BT.
- A live oak 9 ins. in diam., bears S. $66\frac{1}{2}^{\circ}$ E., 78 lks.
dist., mkd. CE $\frac{1}{16}$ S18 RS404 BT.
- N. $0^{\circ} 01' 30''$ W., taking new measurement.

20.29 Point for Northeast $\frac{1}{16}$ sec. cor. at the intersection of
the East and West center line of the Northeast $\frac{1}{4}$
of sec. 18.

Set an iron pipe 3 ft. long 1 in. in diam., 28 ins. in the
ground, from which

- A Douglas fir 18 ins. in diam., bears S. $85\frac{1}{2}^{\circ}$ E., 42 lks.
dist., mkd. NE $\frac{1}{16}$ S18 RS404 BT.
- A Douglas fir 20 ins. in diam., bears S. $44\frac{1}{4}^{\circ}$ W., 74 lks.
dist., mkd. NE $\frac{1}{16}$ S18 RS404 BT.

TOWNSHIP 36 SOUTH, RANGE 4 WEST, W.M., JACKSON COUNTY, OREGON

Dependent Resurvey and Subdivision of Sections 8, 17 & 18

Chains

The corner of section 7, 8, 17 and 18 is monumented with an iron pipe 2 ins. in diam., 8 ins. above the ground, firmly set, from which

A Douglas fir 4 ins. in diam., bears S. $35\frac{1}{2}^{\circ}$ W., 17 lks. dist., mkd. CS BT.

A Douglas fir 3 ins. in diam., bears S. $35\frac{1}{2}^{\circ}$ E., 44 lks. dist., mkd. CS BT.

A Madrona 6 ins. in diam., bears N. $27\frac{1}{2}^{\circ}$ W., 47 lks. dist., mkd. CS BT.

The geographic position of this corner is latitude $42^{\circ} 26' 48''$ N., and longitude $123^{\circ} 12' 40''$ W.

May 8, 1961 at this sec. cor. at 10:15 a.m., I set off $42^{\circ} 26' 48''$ N. on the lat. arc; $17^{\circ} 10'$ N., on the decl. arc; of my Gurley solar compass and determine a meridian.

Thence

S. $0^{\circ} 01'$ E., on true line bet. secs. 17 and 18.

20.31 Point for North 1/16 sec. cor. at proportionate distance.

Set an iron pipe 3 ft. long 1 in. in diam., 28 ins. in the ground, mkd. RS404, from which

A Douglas fir 16 ins. in diam., bears S. 51° E., 51 lks. dist., mkd. N 1/16 S17 RS404 BT.

A Madrona 6 ins. in diam., bears S. 37° W., 62 lks. dist., mkd. N 1/16 S18 RS404 BT.

40.62 To the $\frac{1}{4}$ sec. cor. of secs. 17 and 18 which is monumented with an iron pipe $1\frac{1}{2}$ ins. in diam., 8 ins. above the ground, mkd. RS404, from which

A Cedar 20 ins. in diam., bears N. 1° E., 48 lks. dist., healed.

A Madrona 7 ins. in diam., bears S. $88\frac{1}{2}^{\circ}$ W., 25 lks. dist., mkd. $\frac{1}{4}$ S18 RS404 BT.

S. $0^{\circ} 19'$ W., taking new measurement.

19.26 To the South 1/16 sec. cor. which is monumented with an iron pipe 1 in. in diam., 8 ins. above the ground, mkd. RS404, from which

A yellow pine 30 ins. in diam., bears N. $20\frac{1}{2}^{\circ}$ E., 28 lks. dist., mkd. S 1/16 S17 RS404 BT.

A yellow pine 32 ins. in diam., bears S. $35\frac{1}{2}^{\circ}$ W., 70 lks. dist., mkd. S 1/16 S18 RS404 BT.

38.52 To the sec. cor. of secs. 17, 18, 19 and 20 which is monumented with an iron pipe 2 ins. in diam., 8 ins. above the ground, mkd. RS404, from which

A white oak 8 ins. in diam., bears N. 43° E., 14 lks. dist., mkd. T36S RLW S17 RS404 BT.

TOWNSHIP 36 SOUTH, RANGE 4 WEST, WILLAMETTE MERIDIAN

JACKSON COUNTY, OREGON

DEPENDENT RESURVEY

AND

SUBDIVISION OF SECTIONS 8, 17 & 18

EXECUTED AT THE REQUEST OF J. H. BAXTER AND COMPANY

OF

GRANTS PASS, OREGON

BY

Marvin C. Ramsey, Registered Professional Land Surveyor.

Assistants

James Goodin

George N. Young

Sherman Egger

Paul E. Jonas

Keith Britton

Survey commenced May 8, 1961

Survey completed November 24, 1961

(See Survey No. 2315 for correction in Section 8)