


NOTE:
NORTH ON THIS SURVEY
= N 0°07'31"E BY SOLAR
OBSERVATION

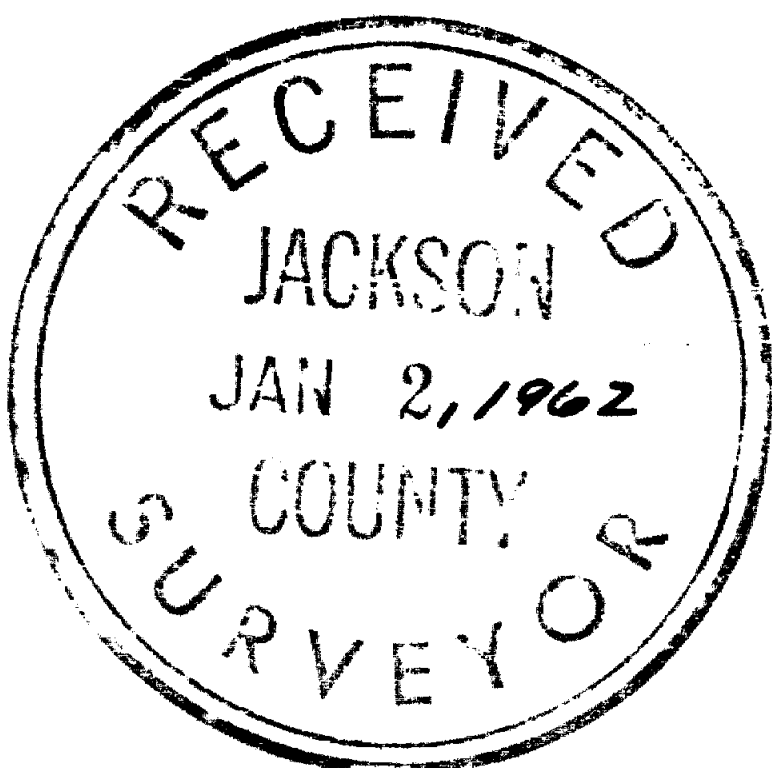


SURVEY IN SE 1/4 SE 1/4 OF SECTION 2, T37S, R4W, W.M.

SCALE: 1 INCH = 100 FT.

OCTOBER 16, 1961 R. M. THOMPSON

DONE FOR:
LOUIS J. COWIE SR.
RTE. 1, BOX 335
GOLD HILL, OREGON

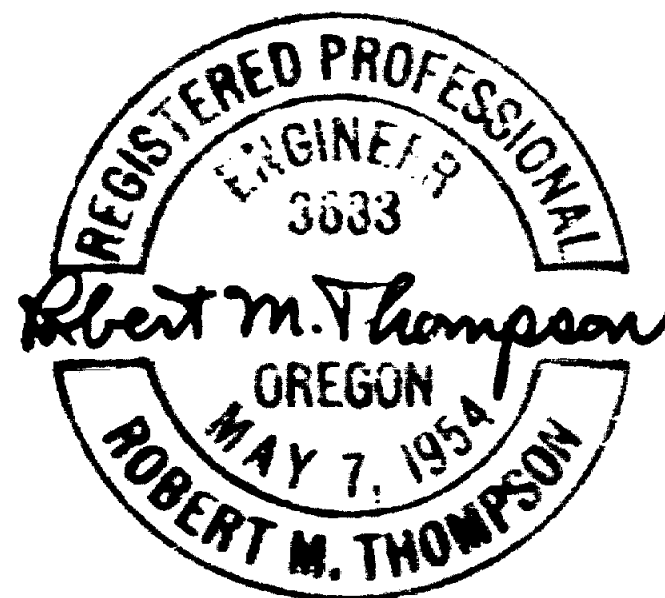

1839
O = SET 1/2" I. PIPE
C = FOUND 3/4" I. ROD

FOUND 2 UNRECORDED
B.T.'S SCRIBED "CS BT"
IN APPROX. 1955:
8" OAK, N37°37'E, 140.25';
15" YEL. PINE, S33°42'E, 16.83'

FOUND 2" GALV. I. PIPE + RENEWAL
B.T. MARKED BY C.Z. BOYDEN, 1927, ROT-
TED STUMP OF 48" YEL. PINE, N39°20'E,
286.7' (2850' MEAS.), FD. SLAB W/ "BT"
SCRIBE VISIBLE

SURVEY NARRATIVE TO COMPLY WITH PAR. 209.250, O.R.S.


Survey in SE $\frac{1}{4}$ SE $\frac{1}{4}$ of Section 2, T37S, R4W, W.M.

For: Louis J. Cowie, Rte. 1, Box 335, Gold Hill, Oregon

Purpose: To cut off Southerly end of Cowie property, set corners and provide description thereof.

Procedure: Beginning at the Southeast corner of Section 2 (see map) I retrace portion of the Easterly boundary of the State's Foot's Creek Gravel Bar, finding it substantially agrees with State Highway Dept. Drawing No. 10C-11-20, Rock Point to Blackwell Hill Section, and Deed V372 P444; this boundary is the Westerly line of the Cowie Property. I then establish center line of the L. Fork of Foots Creek County Road, and a portion of its Westerly right-of-way line at 30 feet distant.

At an approximate point indicated by Mr. Cowie I set a $\frac{1}{2}$ " iron pipe on said right-of-way line for a northeast property corner, and run N42°53'E at right angle to County road, 310.52 feet to point of intersection with State's Easterly line, and set a $\frac{1}{2}$ " iron pipe for northwest property corner. Then, retracing Westerly line of the Robert McManus Placer Mining Claim, (V232P154), I set $\frac{1}{2}$ " iron pipe where said claim line intersects said Westerly right-of-way line. Thence continue Southerly along said claim line, on portion which forms common line with Cowie property, to the point of beginning.

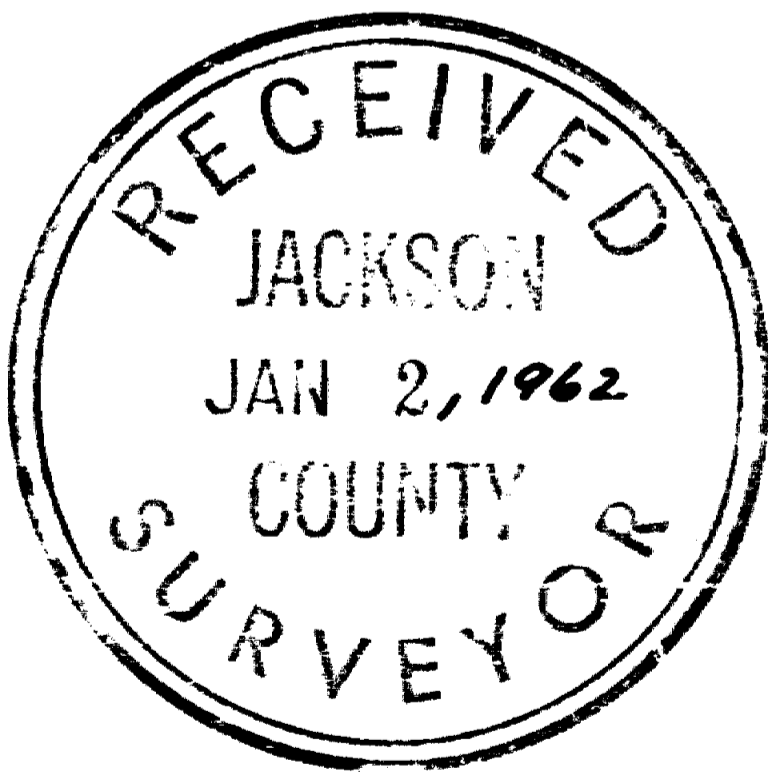

Robert M. Thompson
Robert M. Thompson, R.E. 3683