


Edward A. McGinty

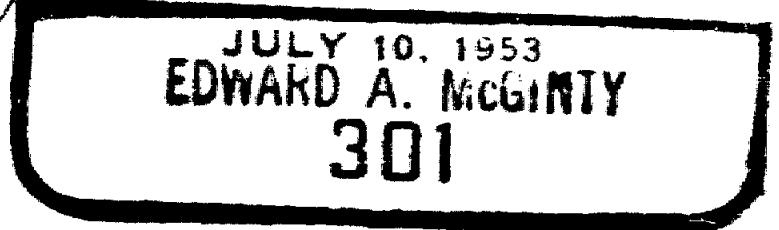

Fd 3/4" in Conc. Mon. 2
 Pipe 28.12 30'
 Fd 3/4" Pipe
 2nd STREET
 Fd 3/4" I. Pin 1.5' ESE. from Mon. Case See City Bk 60 P25
 See Sur. No. 803

**SURVEY LT. 4 BLK 1 ANDERSON-TOFT ADDITION
 FOR
 GENE FORESEE
 61 - 39**

**BY EDWARD A. MCGINTY
 MEDFORD OREGON
 OCTOBER 1961**

**SCALE 1" = 100'
 ● = 5/8" I. PIN
 x = CROSS ON WALK**

Survey No. 1845

Survey Narrative to comply with O.R.S. 209-120 and O.R.S. 209-205.

Survey for: Gene Foresee

Survey by: Edward A. McGinty, L.S.
10/31/61


PRECEDENCE OF SURVEY:

In determining the center line of Oak St., monuments at Jackson St. and 2nd St. were held, this gave a slightly different intersection at Haven St than City records indicated. Consulted with the City Engineers office on this matter and they stated possibilities of reference may be in error at Haven St. The plat of Anderson Toft Add. shows center line of Oak St. and the East line of the Sub-division being a straight line. Previous survey No. 803 also shows Oak St. a straight line

The east line of the Sub-division was determined by holding record distance along Jackson St. and 2nd St., making the east line^a straight line and 180 ft. from the center of Oak St.

the center line of Haven St. was determined from monuments found at Holly St. and iron spike found at Woodstock St.

Lot 4 Block 1 staked at proportional distance north and south, and record distance east and west.

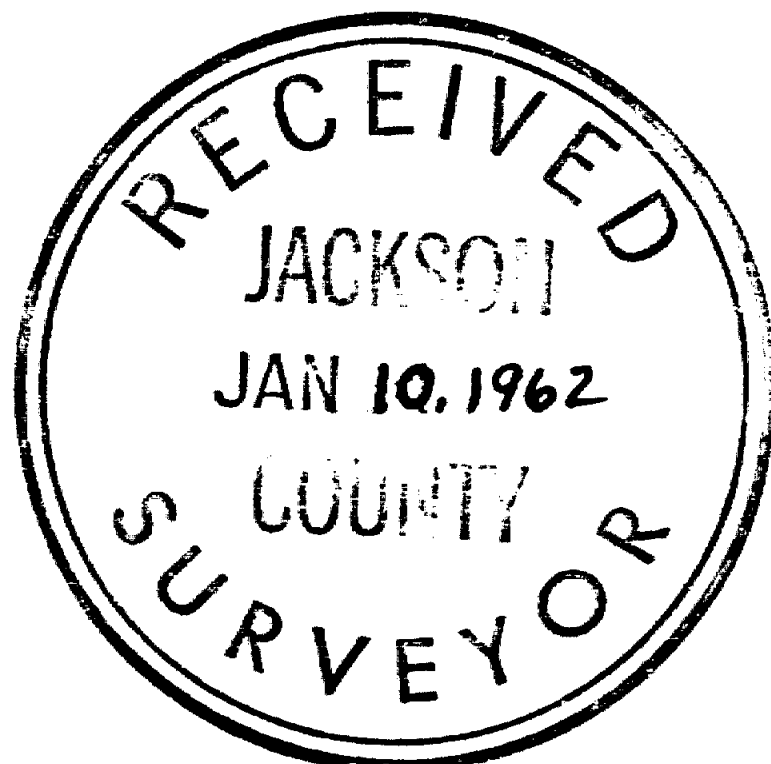

Edward A. McGinty

