SURVEY BY: L.J. FRIAR & ASSOCIATES, P.C. CONSULTING LAND SURVEYORS 816 WEST EIGHTH STREET MEDFORD, OREGON 97501 PHONE: (541) 772-2782 EMAIL: Ijfriar@charter.net

381W05 TL5400

MAP OF SURVEY Located in DLC #50 & in the N.W. 1/4 of Sec. 5, T.38S., R.1W., W.M. Jackson County, Oregon

Jim Griffith P.O. Box 298 Prospect, OR 97536 LEGEND:

= FD. COUNTY SURVEYOR'S BRASS CAPPED MONUMENT PER RE-ESTAB'S.

= FD. 1.5" IRON PIPE PER FS22.

■ = FD. 5/8" IRON PIN W/ PLASTIC CAP MKD. SMITH LS2011 PER FS16809. O = SET 5/8" X 30" IRON PIN W/ PLASTIC CAP MKD. L.J. & ASSOC.

JCDR = JACKSON COUNTY DEED RECORDS.

ORJCO = OFFICIAL RECORDS OF JACKSON COUNTY, OREGON.

WC = WITNESS CORNER.

() = RECORD DATA AS SHOWN.

DR = DEED RECORD DATA.


FS = FILED SURVEY #.

-X- = FENCE LINE.

BASIS OF BEARINGS:

SURVEY NO. 16809 AS SHOWN HEREON.

UNIT OF MEASUREMENT = FEET DATE: OCTOBER 4, 2004 SCALE: 1" = 60'

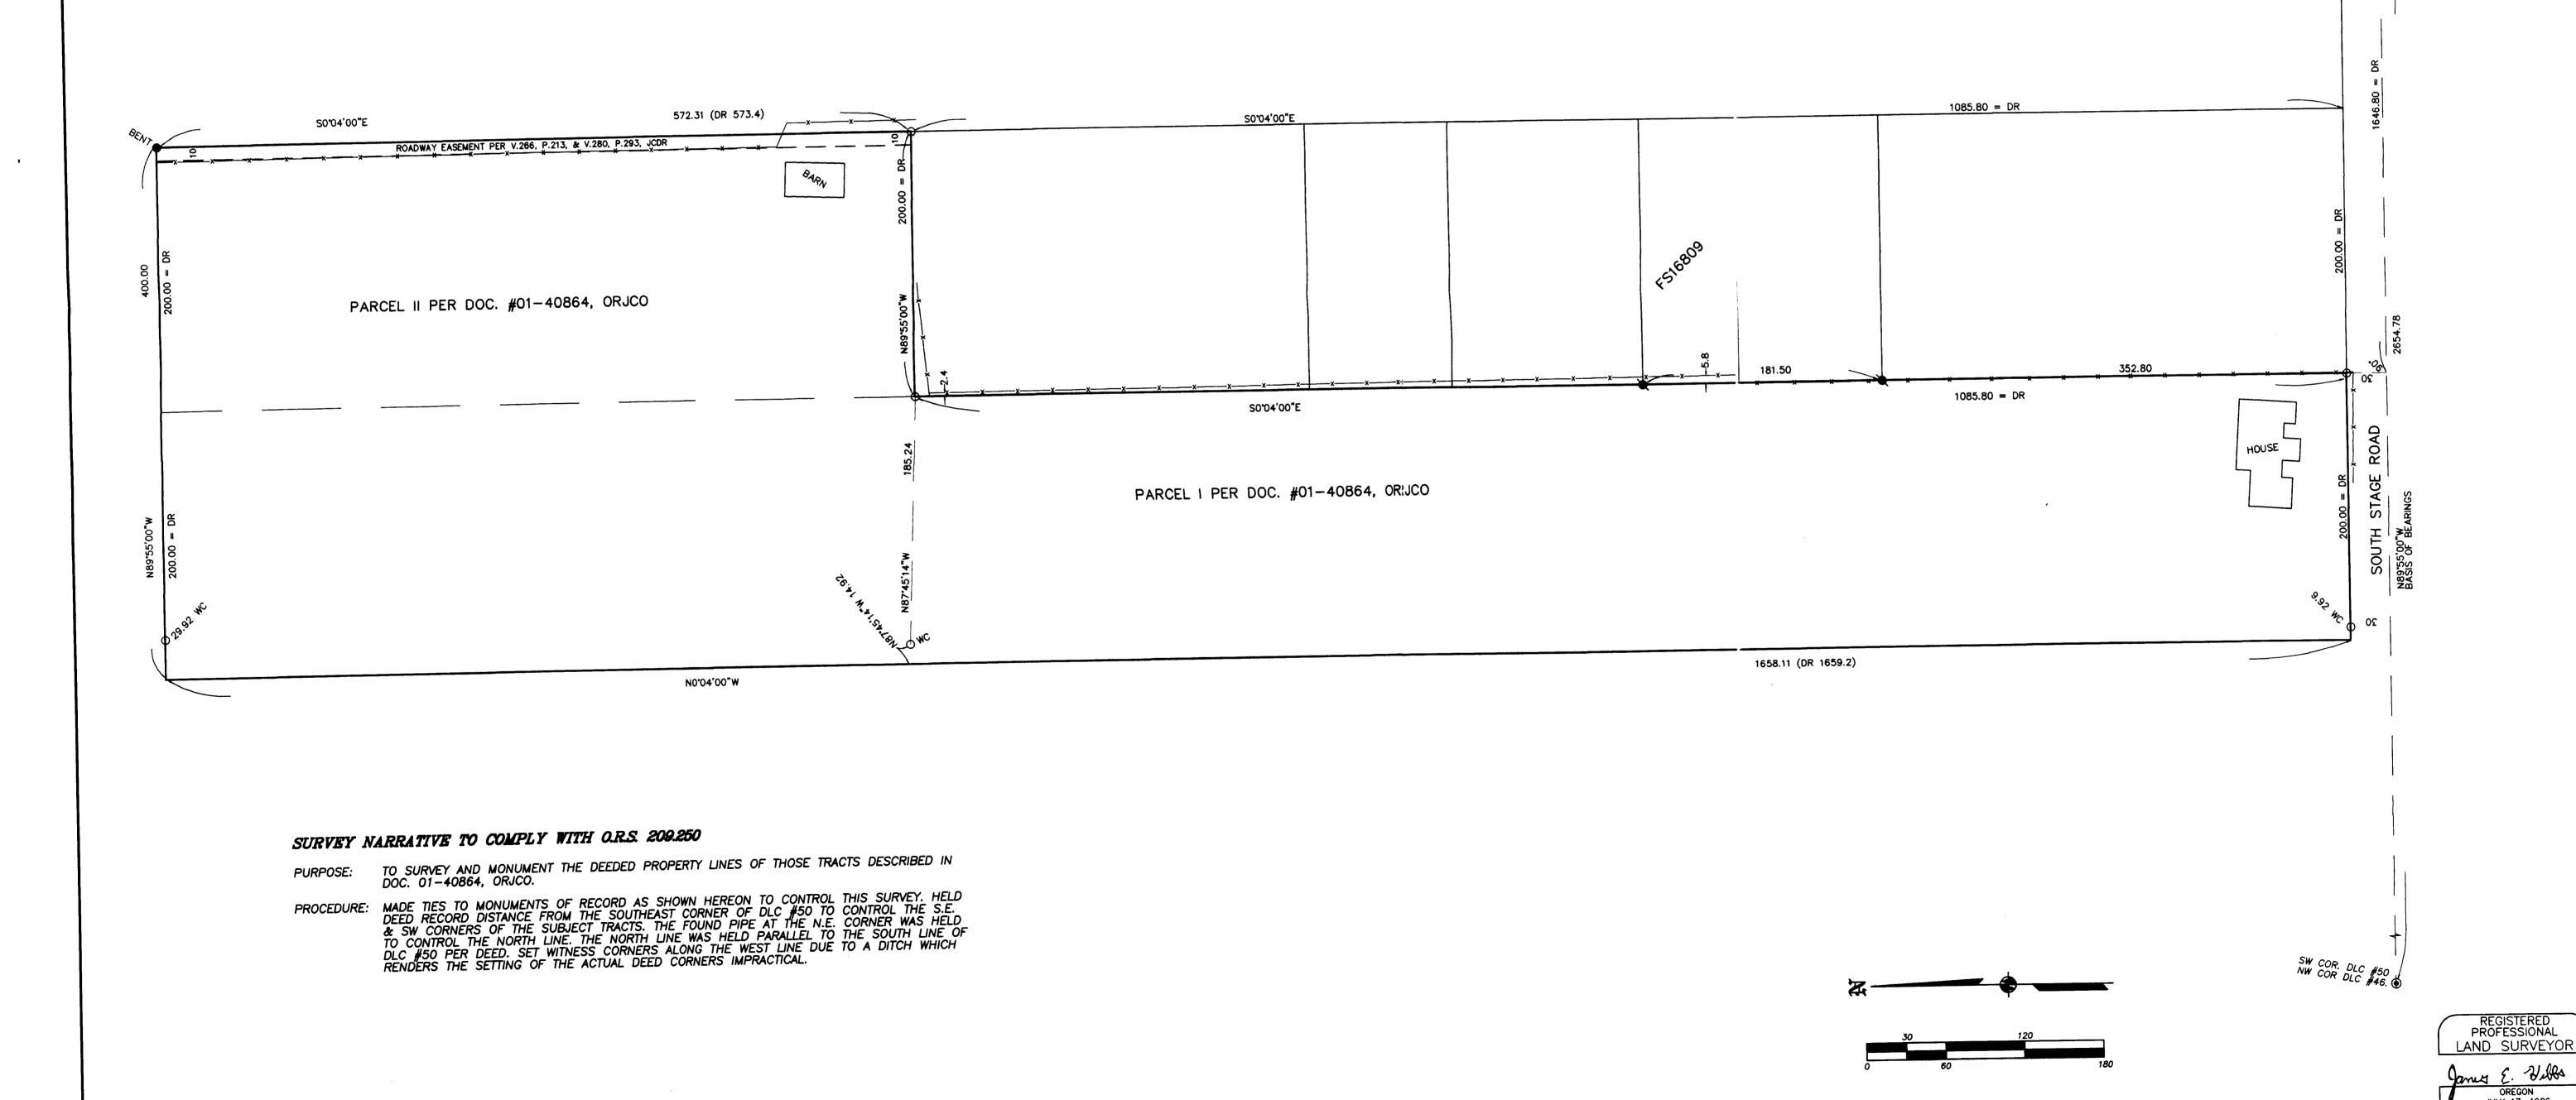

THIS PLAT WAS PREPARED USING AN HP450C DESIGNJET WITH 51640A INKJET INK ON CONTINENTAL JPC4M2 POLYESTER FILM.

18473

* * RECEIVED * *

DATE 10-20-04 BX This survey consists of:

________page(s) Narrative

JACKSON COUNTY

SURVEYOR

JULY 17, 1986

JAMES E. HIBBS

RENEWAL DATE 6-30-05