

SURVEY SEC. 28 T.36 S., R.1 W., W.M.
 FOR
 CAL - ORE - RANCHES
 62 - 4

BY EDWARD MC GINTY
 MEDFORD, OREGON
 FEB 1962

SCALE 1" = 200'
 ○ = 5/8" I. PIN
 ● = 3/4" I. PIN

REGISTERED
 OREGON
 LAND SURVEYOR

Edward A. McGinty
 JULY 10, 1953
 EDWARD A. MCGINTY
 301

RECEIVED
 JACKSON
 FEB 28 1962
 COUNTY
 SURVEYOR

1859

1859

1/4 Cor. 1859

Survey No. 1859

Survey Narrative to comply with O.R.S. 209-120 and O.R.S. 209-205.

Survey for: Cal-Ore-Ranches

843 E. Main, Madras

Survey by: Edward A. McGinty, L.S.

2/7/62

BASIS OF BEARING: Solar Observation.


PRECEDENCE OF SURVEY:

From previous survey of records of Bud Hoovers, sub-divided Section 28.

The north 1/4 corner was replaced by a 3/4 inch iron pin, previously being a 1 inch iron pipe, as shown on Rogueland Irrigated Orchard Tract.

The center line of the County road, according to records, previously followed the 1/16 line, however, this varied considerably with the actual location of the existing road.

The center line of the road was determined, as shown on the map. The procedure used was discussed with the County Engineer.

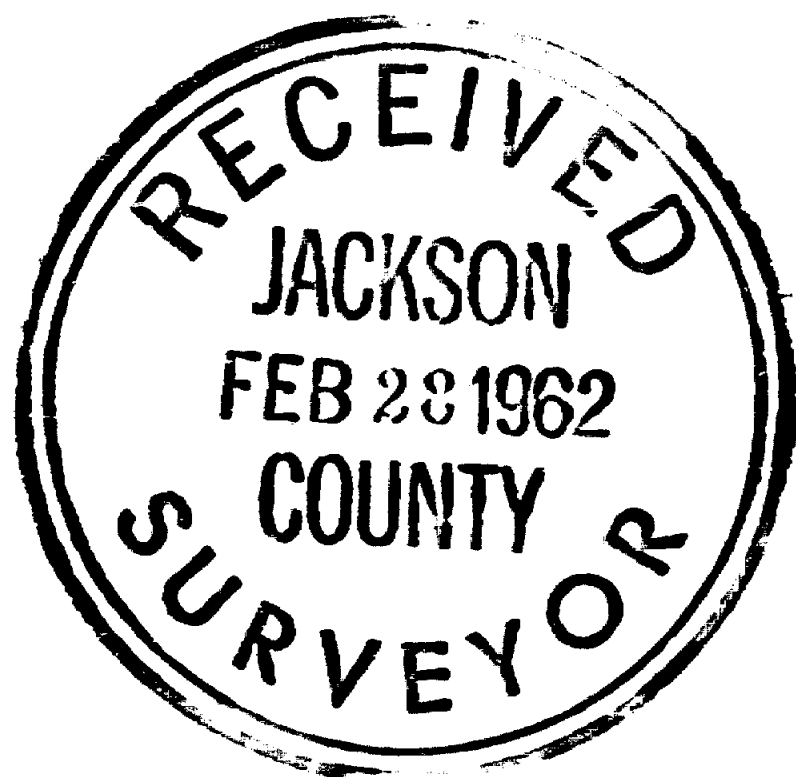

Edward A. McGinty

