

CALCU. - N 0° 06' 00" E 2647.43'

1323.72'

1323.71'

1419.48'

N 89° 29' E 2748.58'

3/4" PIN

1329.10'

1345.79'

N 89° 56' 30" E

1331.18'

SO° 18' 30" W

1333.12'

SE 1/4 X NW 1/4

N 0° 24' 10" E
1328.53'

1333.33'

SUR. NO. 682 = 1405.32'

N 89° 51' 40" W

S 52° 09' 10" E 47.98'


481.96'

FD. PIPE

34.88'

N 20° 29' 20" E

STERLING CH. 20

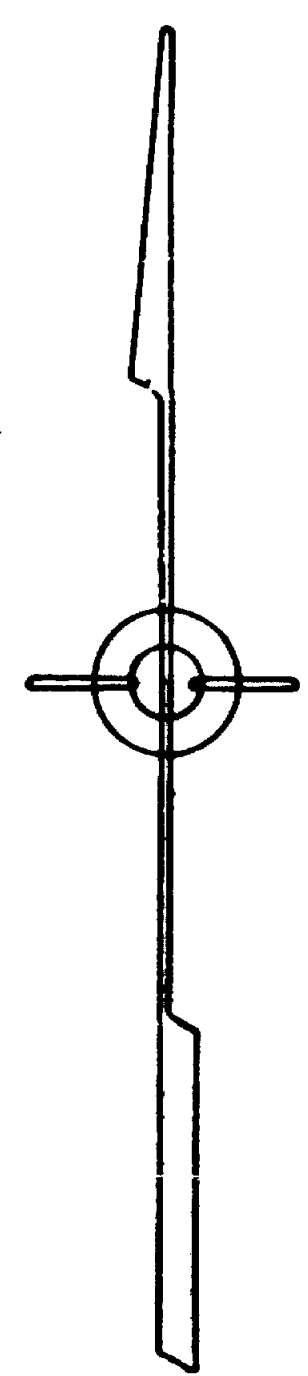

SURVEY IN SEC. 6 T. 38 S., R. 2 W., W.M.

FOR
TED RUNDLE

BY EDWARD A. MC GINTY 62-8
MEDFORD, OREGON
FEBRUARY, 1962

SCALE 1" = 200'
● = 5/8" PIN FD.
○ = 3/4" PIPE FD.

REGISTERED
OREGON
LAND SURVEYOR

Edward A. McGinty
JULY 10, 1953
EDWARD A. MCGINTY
301

1873

Survey No. _____

Survey Narrative to comply with O.R.S. 209-205 and O.R.S. 209-120.

Survey for: Ted Rundle *Jacksonville*

Survey by: Edward A. McGinty, L.S.
3/1/62

BASIS OF BEARING: Survey No. 1673.


PRECEDENCE OF SURVEY:

Sub-divided the northwest quarter of Sec. 6, traversed the northerly line and the easterly line and the southerly line of the East half of the northwest quarter.

The south line of the East half of the northwest quarter of this survey was in agreement with Sur. No. 682. By calculations Sur. No. 682 was projected westerly to the west quarter corner of Sec. 6 and the distance calculated to the northwest corner of Sec. 6.

Also surveyed a small triangle at the request of the adjacent owner, as shown.

62-8

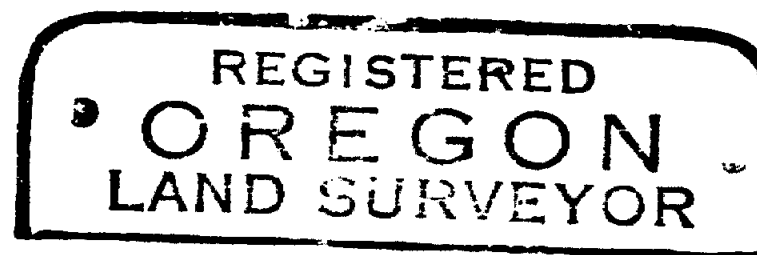

Edward A. McGinty

