18747

MAP OF SURVEY

LOCATED IN:
THE N.E. 1/4 OF SECTION 1, T.37S., R.2W., W.M.
JACKSON COUNTY, OREGON

FOR:

RICHARD WOOTON
4570 TABLE ROCK ROAD
CENTRAL POINT, OREGON 97502

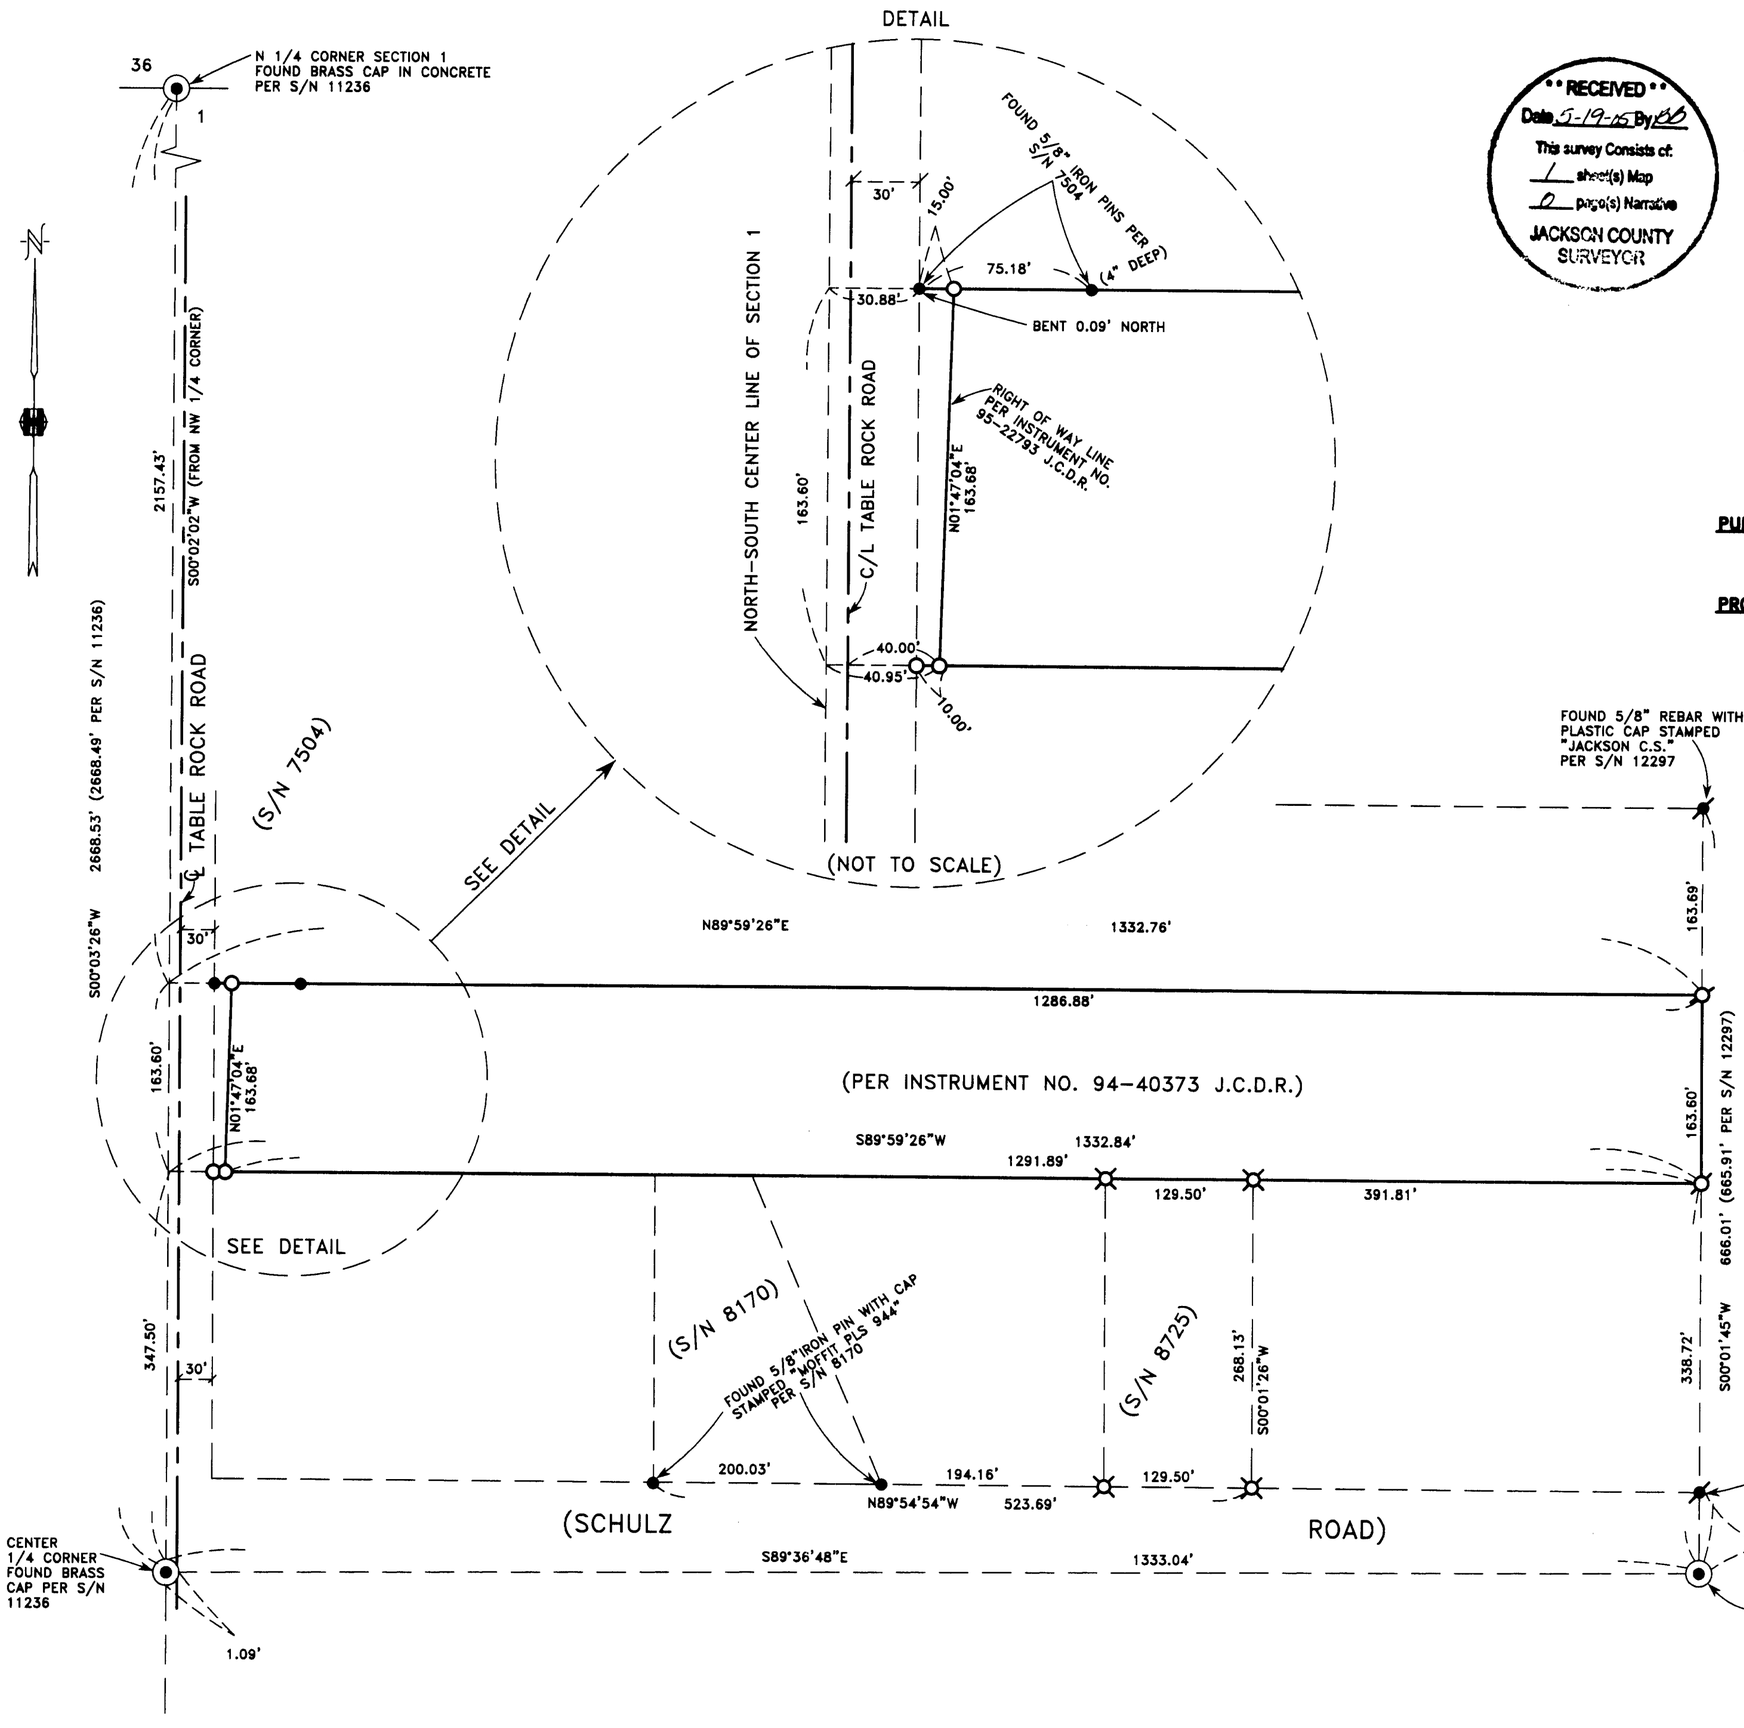

RECEIVED
Date 5-19-05 By BB
This survey Consists of:
1 sheet(s) Map
0 page(s) Narrative
JACKSON COUNTY SURVEYOR

SURVEY NARRATIVE TO COMPLY WITH PARAGRAPH 209.250 OREGON REVISED STATUTES

PURPOSE: TO AMEND MAP OF SURVEY FILED AS SURVEY NO. 18117, TO SHOW ADDITIONAL MONUMENTS THAT WERE SET DURING SURVEY DONE IN 1995.

PROCEDURE: UTILIZING INFORMATION FROM THE MAP OF SURVEY FILED AS SURVEY NUMBER. 18117, I AM FILING THIS MAP OF SURVEY TO SHOW MONUMENTS THAT WERE ESTABLISHED FOR THE AREA BEING DEDICATED FOR ADDITIONAL STREET RIGHT-OF-WAY. SEE NARATIVE ON SURVEY NO. 18117. ALL MONUMENTS SHOWN AS FOUND ARE PER SURVEY NO. 18117 AND WERE NOT VISITED FOR THIS MAP OF SURVEY.

HOFFBUHR & ASSOCIATES, INC.
880 GOLF VIEW DRIVE, SUITE 201 MEDFORD, OREGON 97504
(541) 779-4641
BY: DOUGLAS C. McMAHAN LS No. 1913

SCALE: 1" = 100' DATE: MAY 18, 2005
BASIS OF BEARING: FILED SURVEY NO. 18117

- ○ = SET 5/8"x24" REBAR WITH PLASTIC CAP STAMPED "D.MCMAHAN LS 1913".
- ⌘ = FOUND 5/8" REBAR WITH PLASTIC CAP STAMPED STAMPED "D.MCMAHAN LS 1913" PER S/N 8725.
- ● = FOUND 5/8" IRON PIN, UNLESS OTHERWISE SHOWN.
- ◉ = FOUND2 1/2" BRASS CAP MONUMENT PER S/N 12297
- ⌀ = FOUND 5/8" REBAR WITH PLASTIC CAP STAMPED STAMPED "D.MCMAHAN LS 1913" PER S/N 18117

S/N = FILED SURVEY NUMBER

J.C.D.R. = JACKSON COUNTY DEED RECORDS

REGISTERED PROFESSIONAL LAND SURVEYOR
Douglas C. McMahan
OREGON JULY 19, 1980
DOUGLAS C. McMAHAN No. 1913
RENEWS 12/31/06

37 2W 01A TL 8300

(03026mos2.dwg)
SHEET 1 OF 1

18747