


**SURVEY FOR:**  
**LAROY O. CENTERS**  
 Located in Lot 1, Block 25 of  
 Dekum's Amended Addition to  
 Gold Hill, Oregon  
 By: Mark E. Boyden  
 March, 1962



- o Fd. 1" Iron pin in conc.
  - Set  $\frac{5}{8}$ " Iron pin
- Scale : 1" = 50'

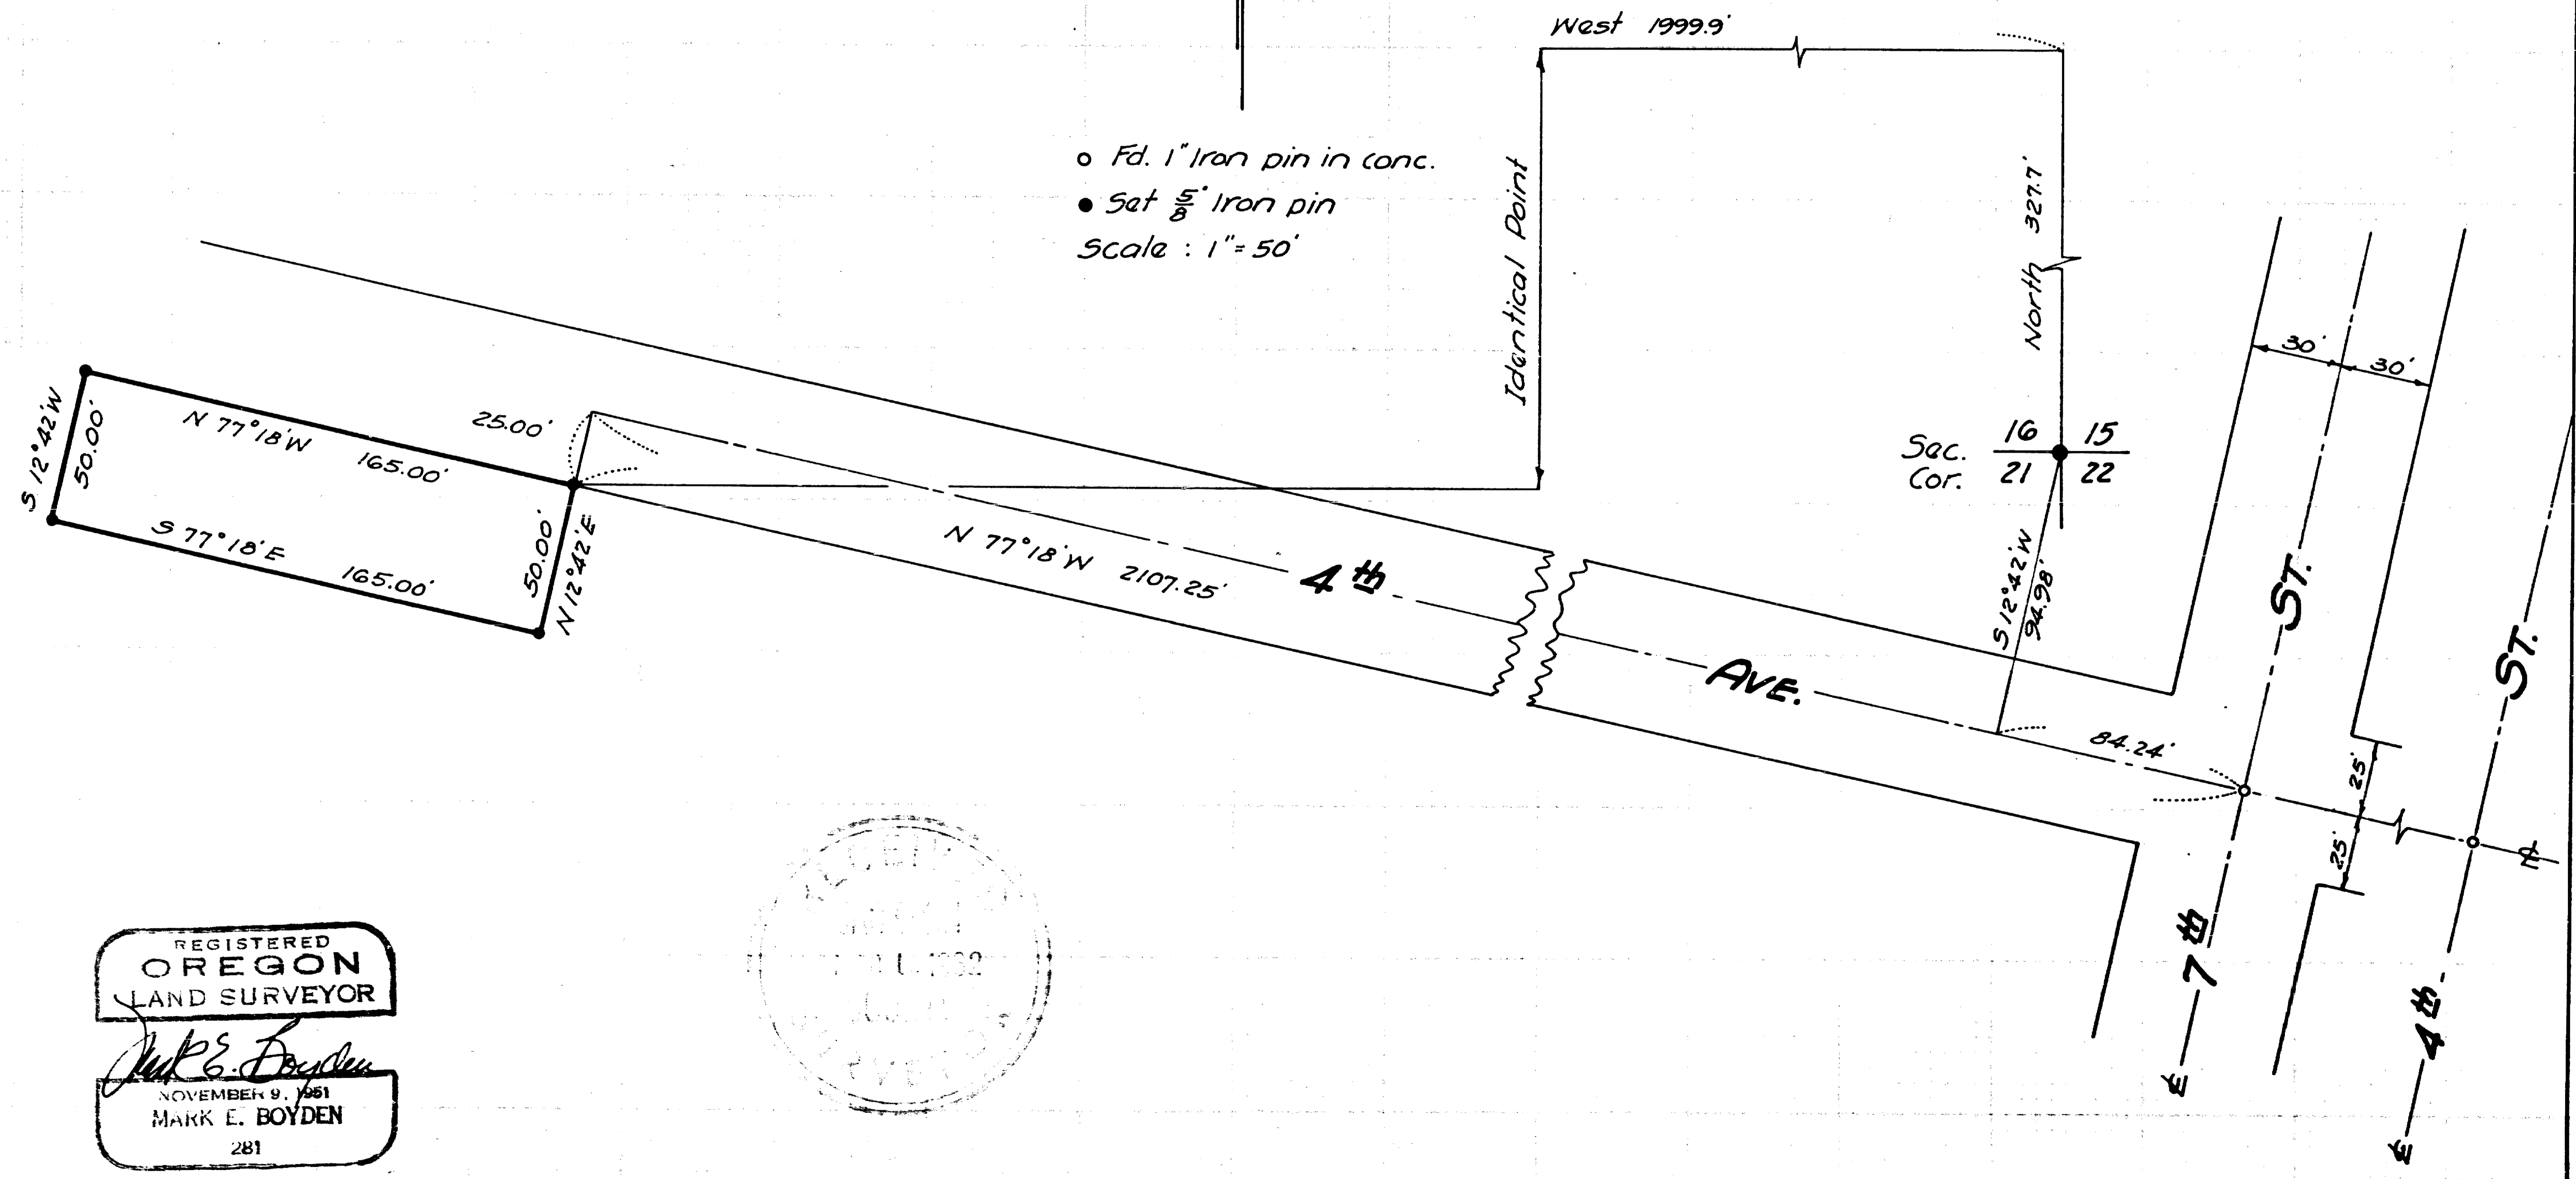

REGISTERED  
**OREGON**  
 LAND SURVEYOR  
*Mark E. Boyden*  
 NOVEMBER 9, 1951  
 MARK E. BOYDEN  
 281



Survey No. 1875

SURVEY NARRATIVE TO COMPLY WITH O.R.S. 209.250

FOR: Laroy O. Centers  
1335 Fourth Avenue  
Gold Hill, Oregon

PURPOSE: To monument and describe a parcel of land lying in Lot 1, Block 25 of DEKUM'S AMENDED ADDITION to the City of Gold Hill, Oregon, being a portion of Tax Deeds recorded in Volume 238, Page 462 and in Volume 521, Page 2 of the Deed Records of Jackson County, Oregon.

PROCEDURE:

From Fourth Avenue centerline control previously established on Recorded Survey No. 1401, projected said centerline North-westerly for street control in DEKUM'S AMENDED ADDITION.

Described said tract by a tie to the Section corner, using for Meridian control, a solar observation taken by this office in 1946.

March 1962

