## Property Line Adjustment



## **SURVEY FOR:**

Eagle Ridge Building & Design Inc. P.O. Box 1082
Eagle Point, OR 97524

LOCATION:

S.E. 1/4 of Section 21, T.36S.,R.1W., W.M., Jackson County, Oregon PROFESSIONAL LAND SURVEYOR

SURVEY BY:

Kaiser Surveying 19754 Highway 62 Eagle Point, OR. 97524 OREGON
JULY 15, 2003
BARY D. KAISER
No. 52923
EXP. 6-30-05

DATE: May 3, 2005

## <u>LEGEND</u>

- = Found 5/8" Iron Pin AGATE SUBDIVISION EXTENTSION NO. 2
- Δ = Found 5/8" Rebar with Plastic Cap marked "B. KAISER RLS 52923" See S.N.'s 18750 & 18751
- ▼ = Found 5/8" Rebar with Aluminum Cap WOODLAKE VILLAGE SUBDIVISION
- **=** Found Monument as Indicated
- Set 5/8" × 30" Rebar with Plastic Cap marked "B. KAISER RLS 52923"
- S.N. = Filed Survey Number County Surveyors Office
- ASE2 = AGATE SUBDIVISION EXTENSION NO. 2
- WVS = WOODLAKE VILLAGE SUBDIVISION
- ( ) = Record/ASE2
- (( ))= Record/S.N. 6911
- (((())) = Record/S.N. 2726

× × Fence

\* \* RECEIVED \* \*

Date 6-2-05 By

This survey consists of:


\_\_\_\_\_ sheet(s) Map
\_\_\_\_ page(s) Narrative

JACKSON COUNTY
SURVEYOR

## SURVEY NARRATIVE TO COMPLY WITH O.R.S. 209.250

PURPOSE: Property Line Adjustment Survey adjusting the boundary between tracts described in Inst. Nos. 75-08777 O.R. and 2004-058958 O.R.

PROCEDURE: The boundaries of the subject properties were located using information on Inst. Nos. 75-08777 O.R. and 2004-058958 O.R., Filed Survey Nos. 2726, 6911 and the Plats of AGATE SUBDIVISION EXTENSION NO. 2 and WOODLAKE VILLAGE SUBDIVISION.

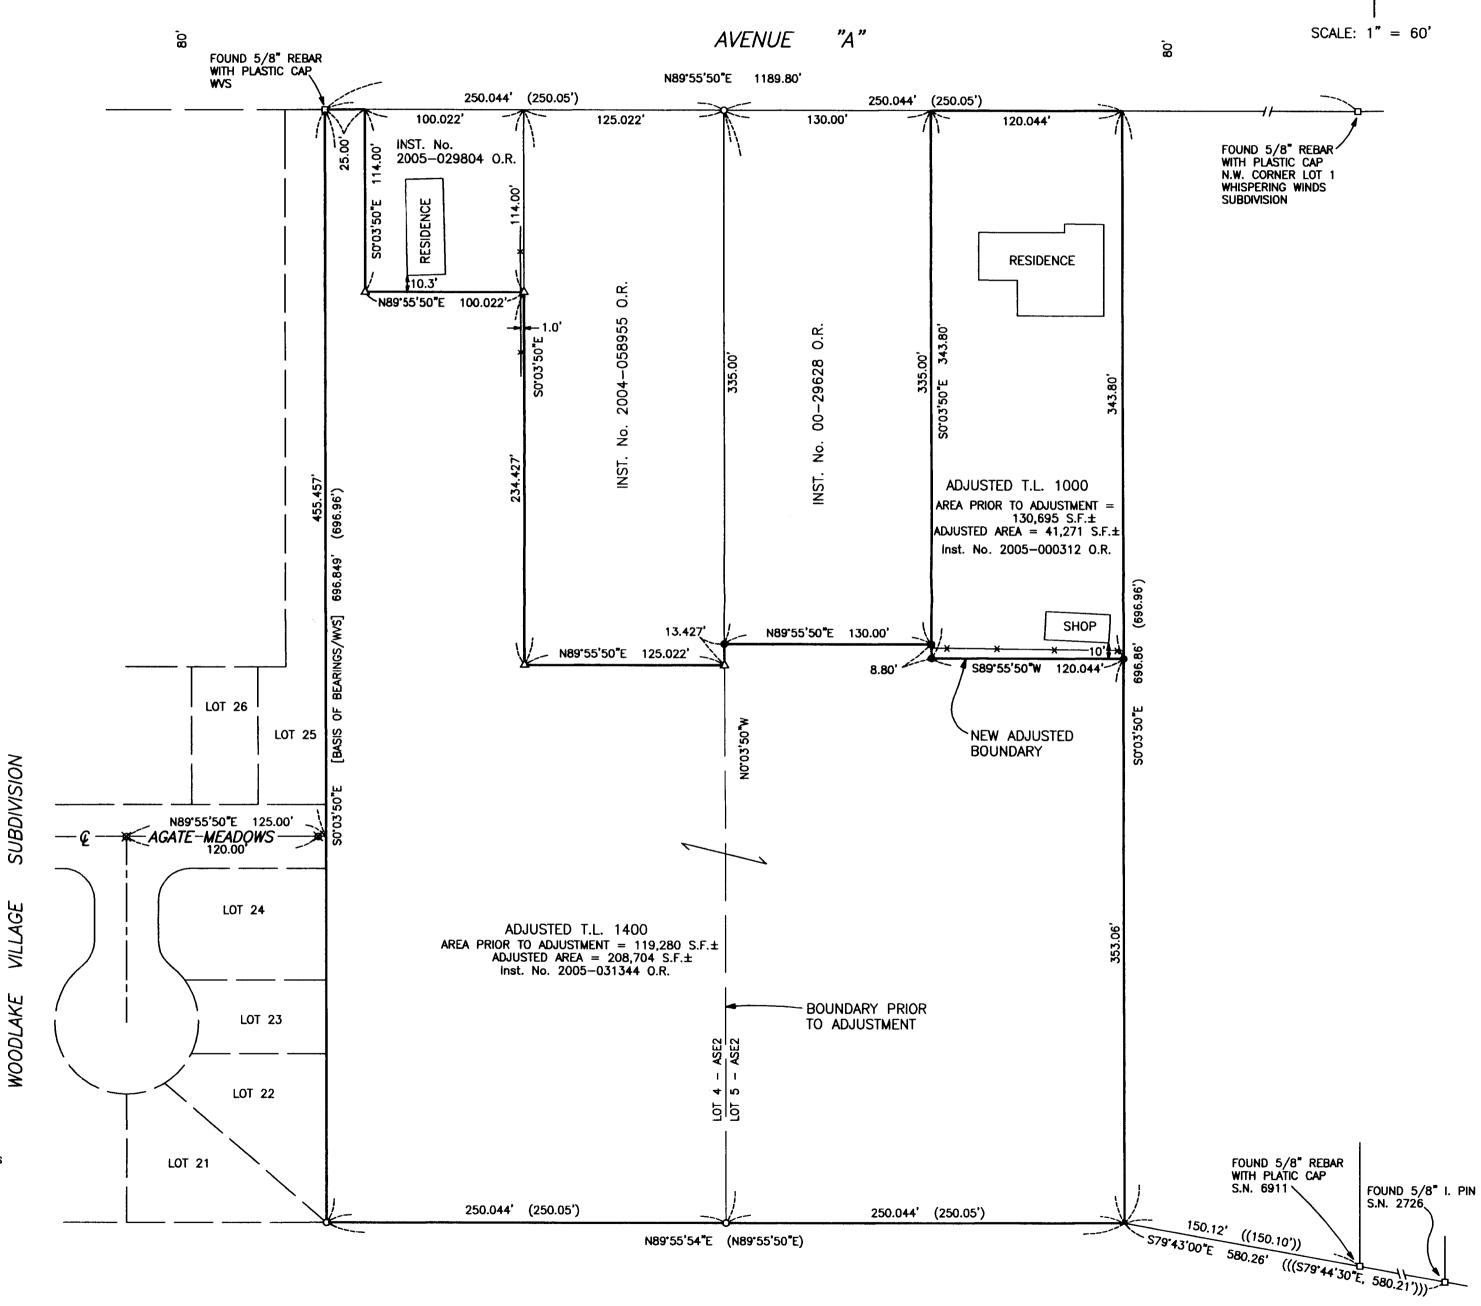

T.L. Nos. 361W 21D - 1000 & 1400