


0881

1880

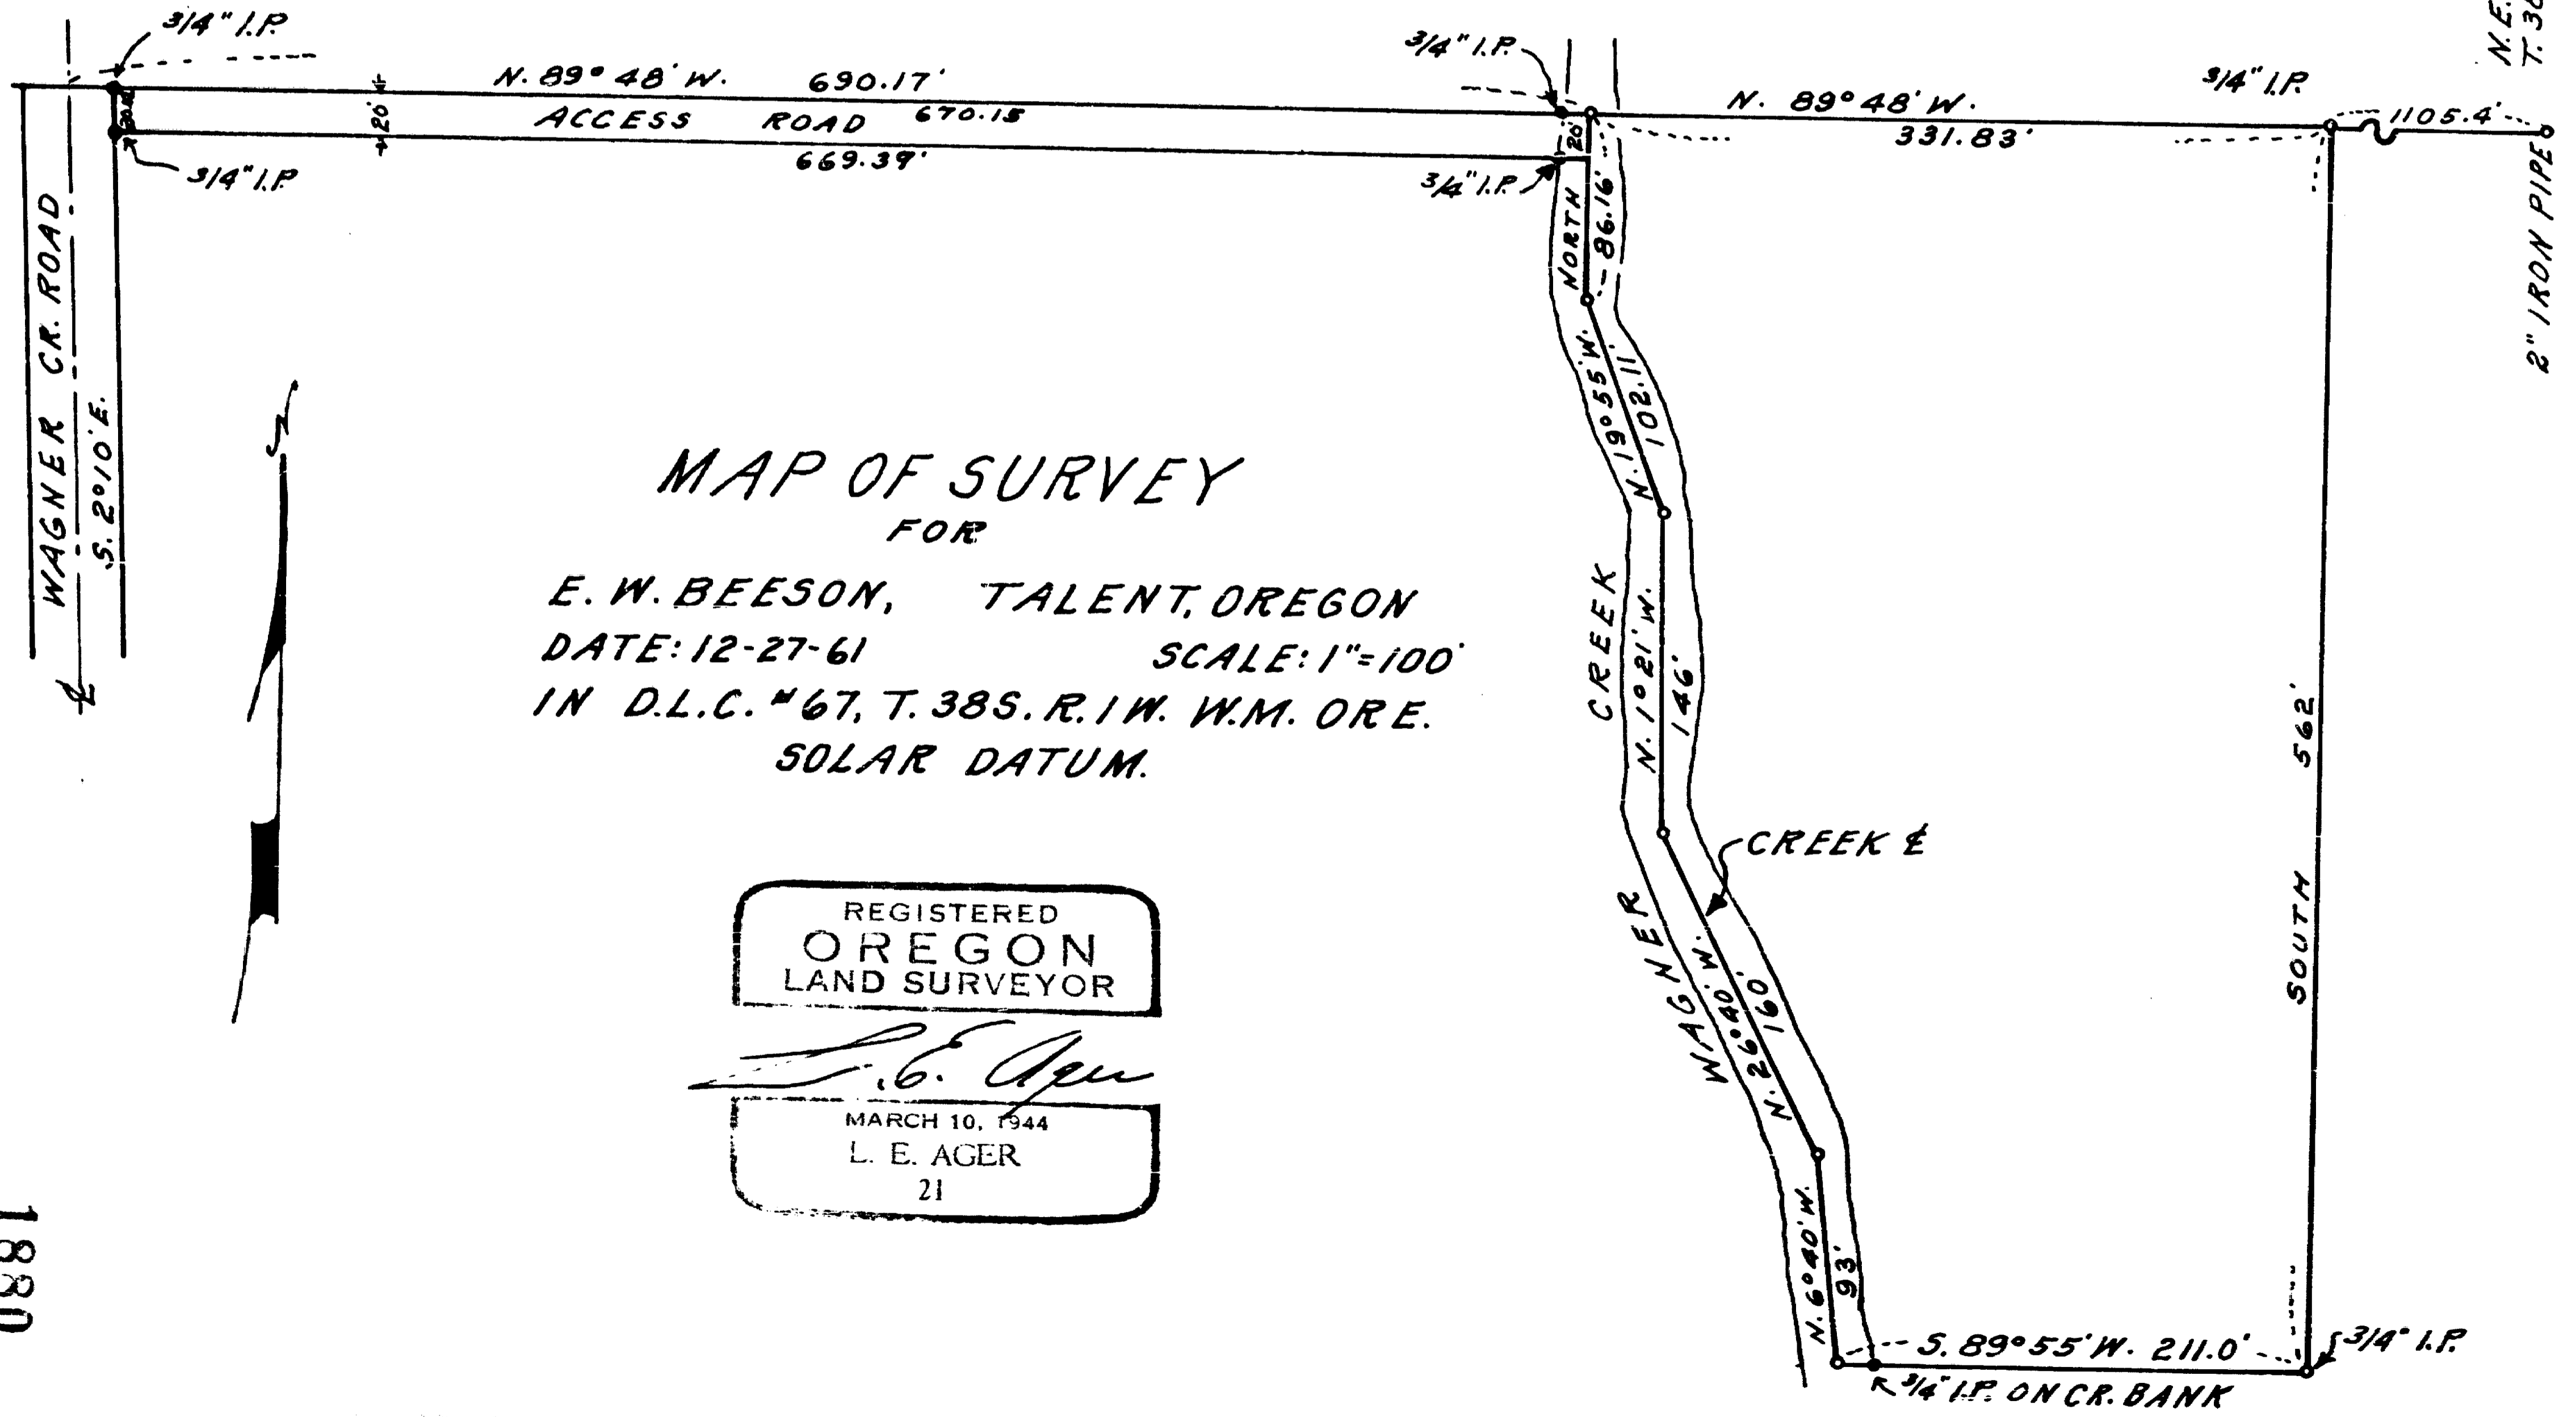

MAP OF SURVEY
FOR

E. W. BEESON, TALENT, OREGON
DATE: 12-27-61 SCALE: 1"=100'
IN D.L.C. #67, T. 38S. R. 1 W. W.M. ORE.
SOLAR DATUM.

REGISTERED
OREGON
LAND SURVEYOR


L. E. Ager
MARCH 10, 1944
L. E. AGER
21

Survey narrative to comply with ORS 209.250


For: E. W. Beeson, Talent, Oregon

Purpose: For boundary corners & description of tracts shown

Proceedure: Found reestablished NW and NE corners of Claim.
On a true line between these corners I set pipes
as shown on the North line of the property shown
on map, boundaries surveyed as shown. Line in creek
angle points coordinated from offset line, no points
set in creek.

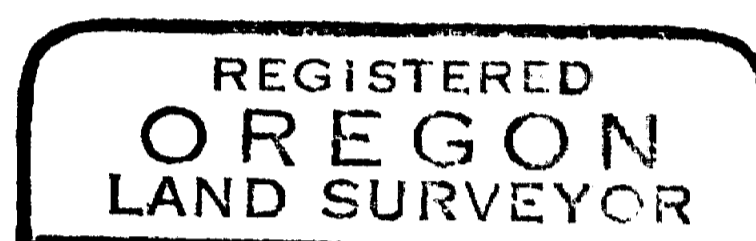

L. E. Ager

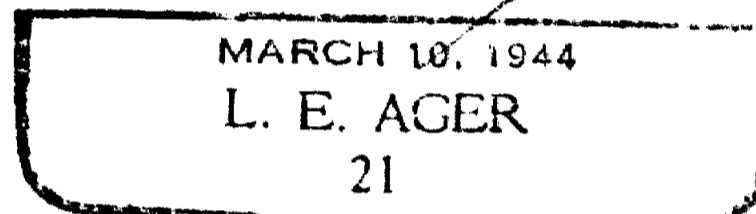


Survey narrative to comply with ORS 209.250

For: E. W. Beeson, Talent, Oregon

Purpose: For boundary corners & description of tracts shown

Procedure: Found reestablished NW and NE corners of Claim.
On a true line between these corners I set pipes
as shown on the North line of the property shown
on map, boundaries surveyed as shown. Line in creek
angle points coordinated from offset line, no points
set in creek.

REGISTERED
OREGON
LAND SURVEYOR

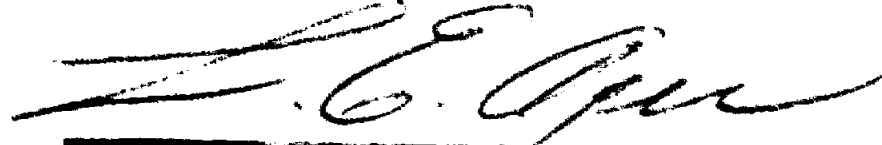


MARCH 10, 1944
L. E. AGER
21

RECEIVED
JACKSON
MAY 26 1962
COUNTY OF
SURVEYOR



N.E. COR. D.L.C. #67
T. 38S. R. 1 W. W.M.

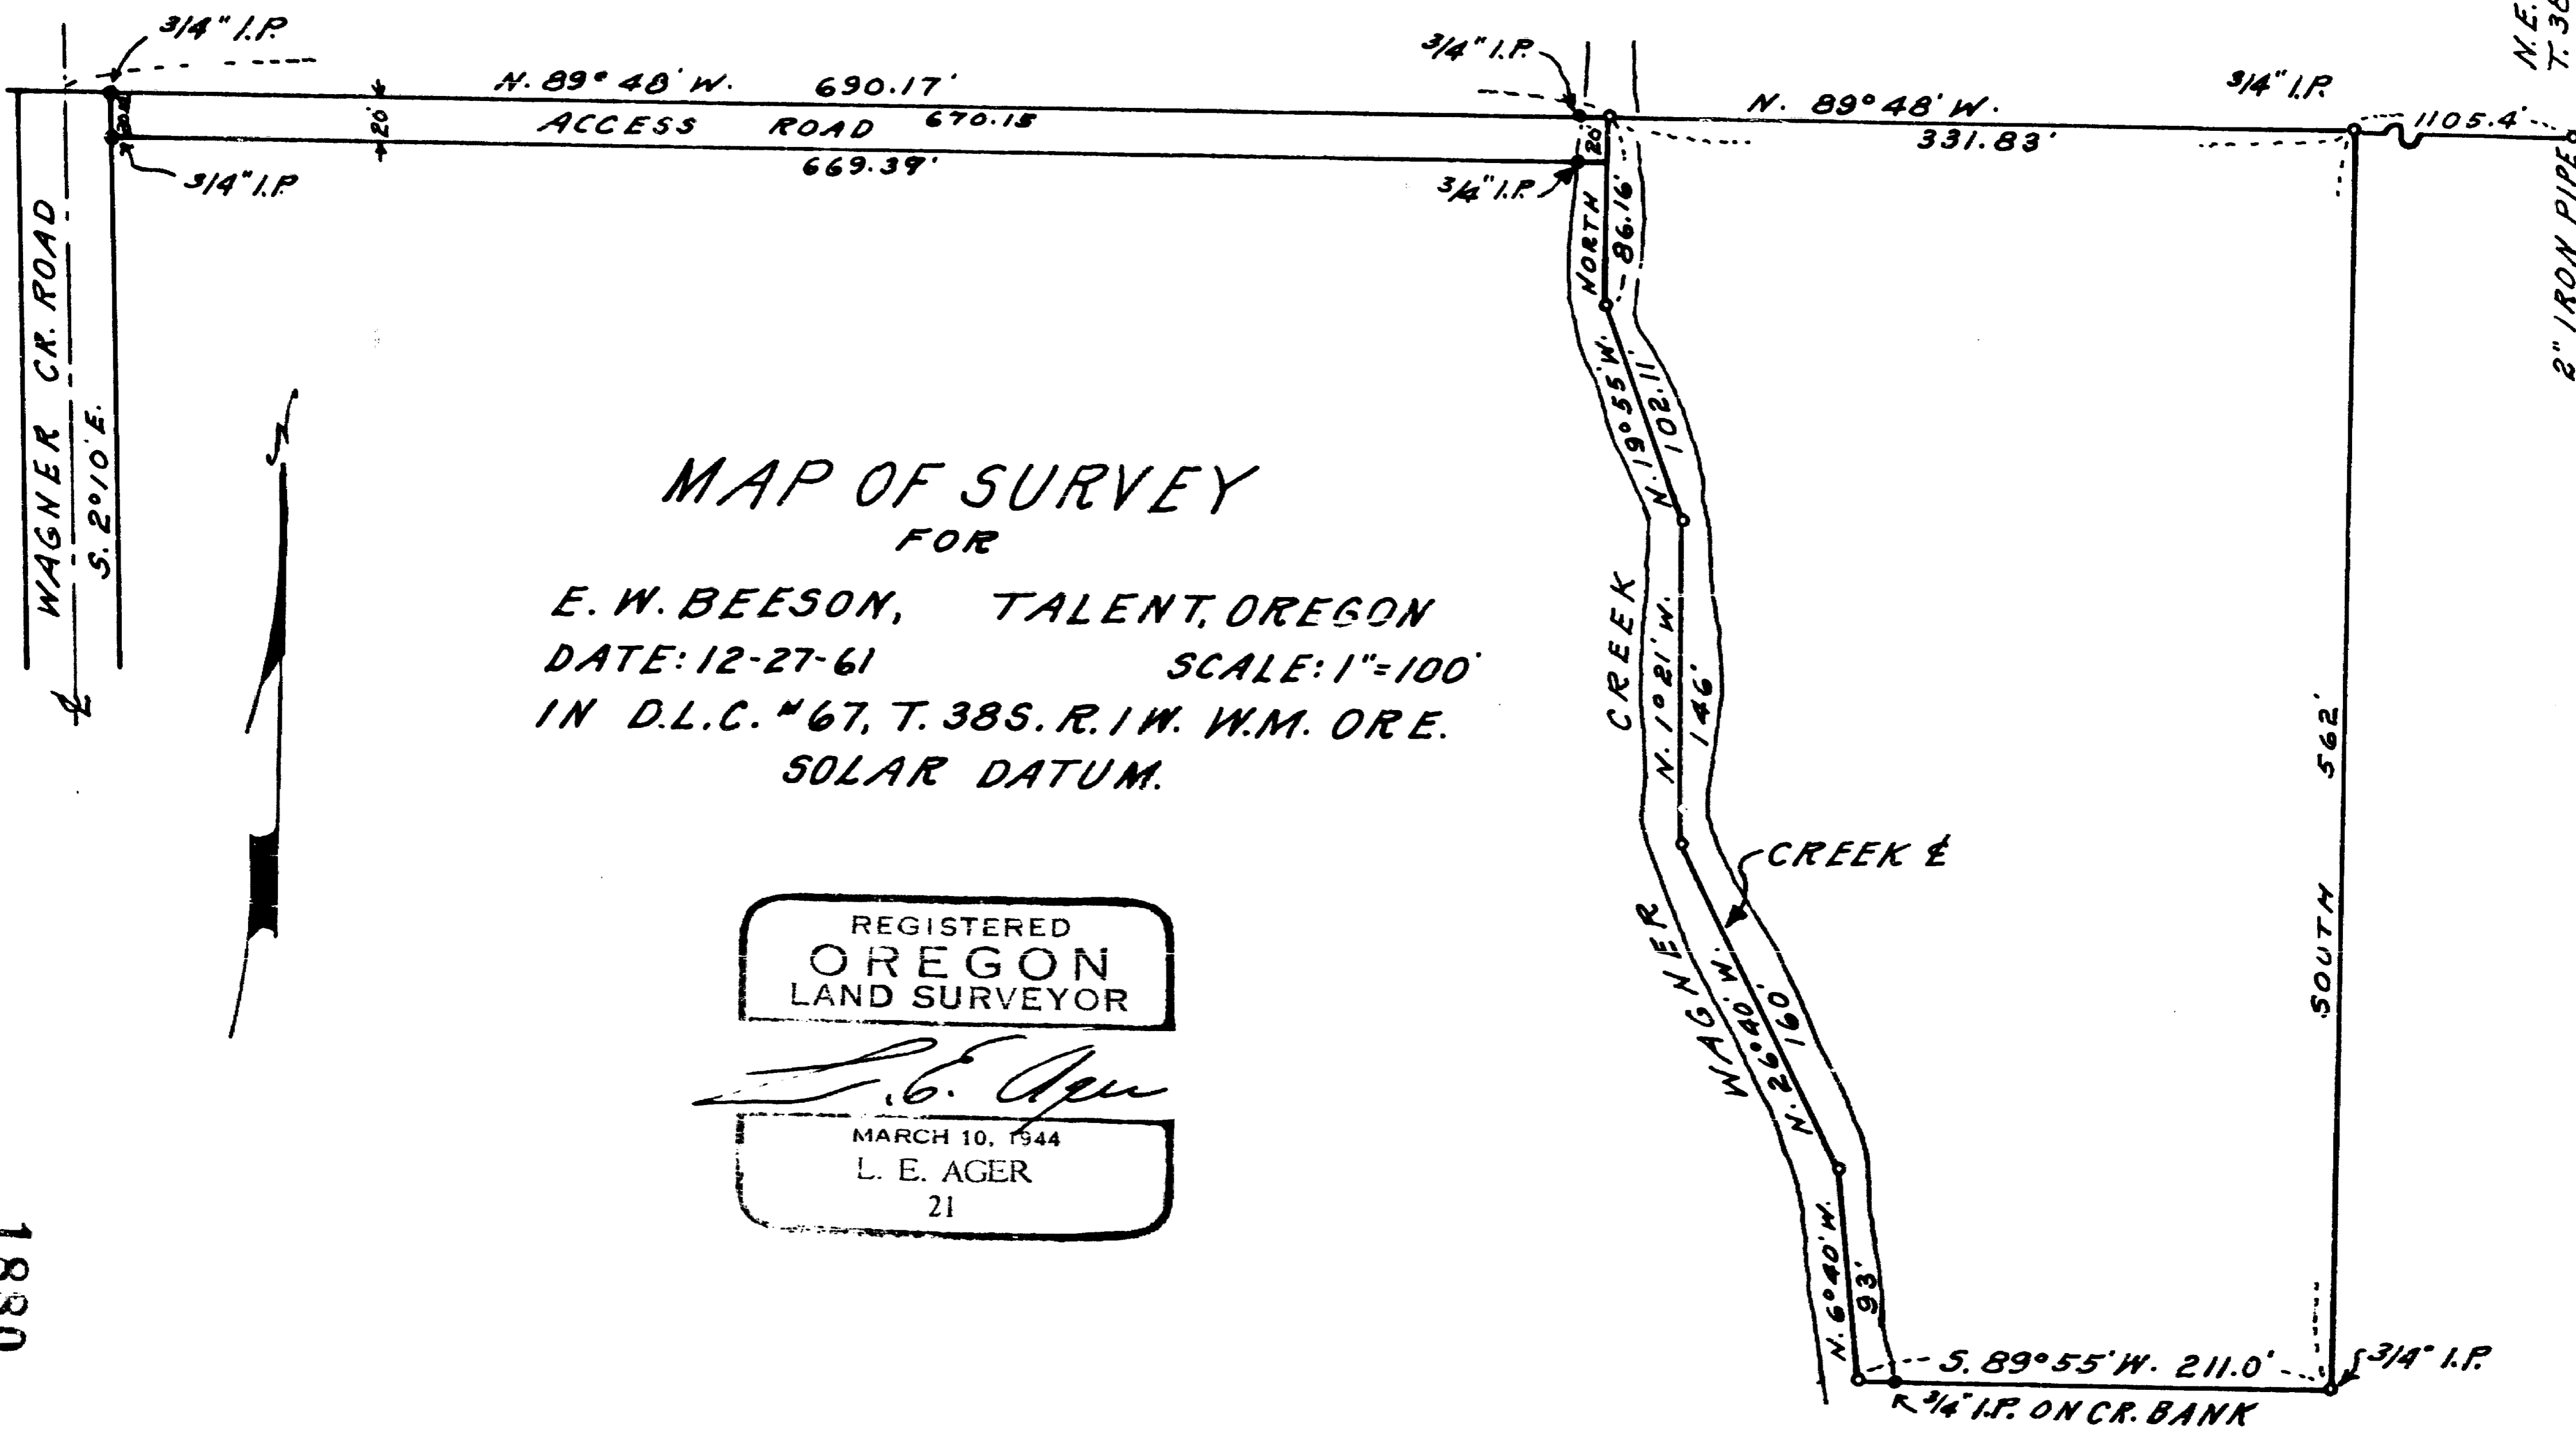

MAP OF SURVEY

FOR
 E. W. BEESON, TALENT, OREGON
 DATE: 12-27-61 SCALE: 1"=100'
 IN D.L.C. #67, T. 38S. R. 1 W. W.M. ORE.
 SOLAR DATUM.

REGISTERED
 OREGON
 LAND SURVEYOR

L. E. Ager

MARCH 10, 1944
 L. E. AGER
 21