

MAP OF SURVEY

located in the
SOUTHWEST ONE QUARTER OF SECTION 34,
TOWNSHIP 35 SOUTH, RANGE 2 WEST,
WILLAMETTE MERIDIAN, JACKSON COUNTY, OREGON

for
Patrick and Marechal Dunlap

13290 Table Rock Road
CENTRAL POINT, OREGON 97502

REGISTERED
PROFESSIONAL
LAND SURVEYOR

OREGON
JULY 26, 1985
HERBERT A. FARBER
2189

RENEWAL DATE 12-31-05

** RECEIVED **
DATE 8-1-05 BY *[Signature]*
This survey consists of:
1 sheet(s) Map
2 page(s) Narrative
JACKSON COUNTY
SURVEYOR

LEGEND


- ⊗ = FOUND SECTION CORNER - AS NOTED
 - ⊠ = FOUND QUARTER CORNER - AS NOTED
 - = FOUND 5/8" IRON PIN, S/N 5401 (OR AS NOTED)
 - = SET 5/8" x 24" IRON PIN w/ YELLOW PLASTIC CAP MARKED "FARBER PLS 2189"
 - ⦿ = SET 5/8" x 24" IRON PIN w/ YELLOW PLASTIC CAP MARKED "FARBER PLS 2189" (REFERENCE MONUMENTS)
- S/N = RECORD FILED SURVEY NUMBER
- BASIS OF BEARING IS TRUE NORTH, NAD 83/91 DATUM, AS DERIVED BY GLOBAL POSITIONING SYSTEM OBSERVATIONS.
- RECORD SURVEY DATA IS SHOWN IN PARENTHESIS ADJACENT TO MEASURED SURVEY DATA WHERE APPLICABLE.
- INST. No. = INSTRUMENT NUMBER AS RECORDED IN THE OFFICIAL RECORDS OF JACKSON COUNTY, OREGON.

SURVEY NARRATIVE
TO COMPLY WITH O.R.S. 209.250

PURPOSE: TO SURVEY AND MONUMENT THE TRACTS DESCRIBED IN INSTRUMENT No. 00-22313 OF THE OFFICIAL RECORDS OF JACKSON COUNTY, OREGON.

PROCEDURE: CONTROLLING CORNERS WERE TIED AND COMPARED TO THE RECORD SURVEY NUMBER 5401. THE TIED LOCATIONS WERE FOUND TO FIT WITHIN ACCEPTABLE LIMITS. THE LOCATION FOR THE WEST ONE-SIXTEENTH CORNER WAS COMPUTED USING THE FOUND POSITIONS OF THE SOUTHWEST CORNER OF SECTION 34 AND THE SOUTH ONE-QUARTER CORNER OF SECTION 34 AND SET AT THE MIDPOINT OF THIS LINE. THE LOCATION FOR THE SOUTHEAST CORNER OF PARCEL 1, TRACT "A" WAS COMPUTED USING THE FOUND LOCATIONS OF THE CENTER-SOUTH ONE SIXTEENTH CORNER AND THE SOUTH ONE-QUARTER CORNER OF SECTION 34 AND SET AT THE MIDPOINT OF THIS LINE. THE LOCATION FOR THE SOUTHWEST CORNER OF PARCEL 1, TRACT "A" WAS COMPUTED USING THE FOUND LOCATION OF THE SOUTHWEST ONE SIXTEENTH CORNER AND THE COMPUTED POSITION OF THE WEST ONE-SIXTEENTH CORNER AND SET 30.00 EASTERLY OF THE MIDPOINT OF THIS LINE ON THE COMPUTED SOUTH BOUNDARY LINE OF PARCEL 1 TRACT "A".

Surveyed by:
FARBER & SONS, INC.
dba FARBER SURVEYING
(541) 664-5599
PO BOX 5286
431 OAK STREET
CENTRAL POINT, OREGON 97502

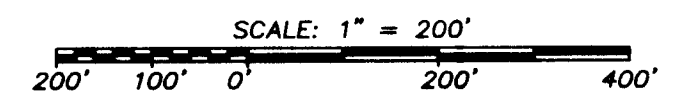

DATE: AUGUST 5, 2005
JOB NO.: 1324-05

JOB\SAM VALLEY AREA\dunlap\microsurvey\map of survey final.flx

