T.L. 500 91–18669 O.R.

384.51

EXUSTING

N 89'57'56" W 2650.25' (2650.74')

74-12880 O.R.

N 89'59'37" W 2651.17'

T.L. 400 91–18671 O.R.

N 89°57'56" W 750.00'

N 89'57'56" W 870.00'

830.00'

67-05606 O.R.

830.00'

KERSHAW

SHAW 18 W SHARINGS F

ROAD W 2648.98' S PER F.S. 10806)

100.00

40' ,40.00'

T.36S.R.1W.S.22D T.L. 400 & 500

FOUND
BRASS CAP
"JACKSON COUNTY"
SOUTH 1/4 CORNER OF
SECTION 22

MAP OF SURVEY

LOCATED IN SOUTHEAST QUARTER OF SECTION 22, TOWNSHIP 36 SOUTH, RANGE 1 WEST, WILLAMETTE MERIDIAN JACKSON COUNTY, OREGON


> SMITH SURVEYING LLOYD R. "BUTCH" SMITH 7050 HIGHWAY 140 EAGLE POINT, OREGON 97524 (541) 826-2509

LEGEND

- FOUND ODOT ALUMINUM CAP, UNLESS NOTED OTHERWISE.
- FOUND BRASS CAP AS NOTED.
- SET 5/8"x24" PIN WITH CAP "LS 2011".
- FILED SURVEY, JACKSON COUNTY SURVEYOR'S OFFICE.
- OFFICIAL RECORDS, JACKSON COUNTY, OREGON.
- RECORD DATA.

PURPOSE: ESTABLISH DEED CORNERS AS REQUESTED BY CLIENT.

PROCEDURE: RECOVERED MONUMENTS ON FILED SURVEY NUMBERS 10806 AND 18067. SURVEYED AND SET MONUMENTS AS INDICATED ON MAP.

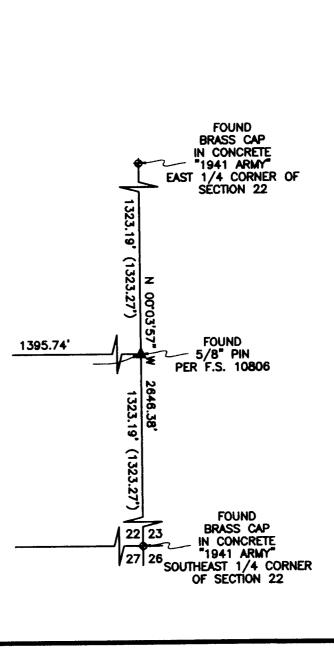

/__ sheel(s) Map D page(s) Narrative JACKSON COUNTY REGISTERED PROFESSIONAL

• RECEIVED • Date 8-80-05 By 100 This survey Consists of:

LAND SUSTEYOR los & Smuth OREGON JULY 16, 1982 LLOYD R. SMITH No. 2011 Exp 6/30/06