

\*\*\* RECEIVED \*\*\*  
 DATE 12-20-05 BY CB  
 This survey consists of:  
 - sheet(s) Map  
 - page(s) Narrative  
 JACKSON COUNTY  
 SURVEYOR

REGISTERED  
 PROFESSIONAL  
 LAND SURVEYOR

*Herbert A. Farber*  
 OREGON  
 JULY 26, 1985  
 HERBERT A. FARBER  
 2189  
 RENEWAL DATE 12-31-05

EXAMINED AND APPROVED BY JACKSON COUNTY DEPARTMENT OF PLANNING  
 AND DEVELOPMENT SERVICES, FILE NO. SUB2005-00021.  
 BY Charles Bennett DATE 9-30-05

MAP OF SURVEY  
 for a  
 PROPERTY LINE ADJUSTMENT

located in the  
 NORTHEAST ONE QUARTER OF SECTION 9,  
 TOWNSHIP 37 SOUTH, RANGE 1 WEST,  
 WILLAMETTE MERIDIAN, JACKSON COUNTY, OREGON

for  
**JIM AND SHARON WARD**  
 3852 FOOTHILL ROAD  
 MEDFORD, OREGON 97501

LEGEND


- = FOUND 5/8" IRON PIN, PER SURVEY NUMBER 6576
  - = SET 5/8" x 24" IRON PIN w/ YELLOW PLASTIC CAP MARKED "FARBER PLS 2189"
  - S/N = RECORD FILED SURVEY NUMBER
  - W.C. = WITNESS CORNER
  - - - = EXISTING FENCELINE
- BASIS OF BEARING IS TRUE NORTH, NAD 83/91 DATUM, AS DERIVED BY GLOBAL POSITIONING SYSTEM OBSERVATIONS.  
 - RECORD SURVEY DATA IS SHOWN IN PARENTHESIS ADJACENT TO MEASURED SURVEY DATA WHERE APPLICABLE.  
 - INST. No. = INSTRUMENT NUMBER AS RECORDED IN THE OFFICIAL RECORDS OF JACKSON COUNTY, OREGON.

SURVEY NARRATIVE  
 TO COMPLY WITH O.R.S. 209.250

PURPOSE: TO SURVEY AND MONUMENT THE ADJUSTED PROPERTY LINE AS APPROVED BY JACKSON COUNTY ROADS, PARKS AND PLANNING SERVICES, FILE NUMBER SUB2005-00021, DATED APRIL 21, 2005.

PROCEDURE: UTILIZING G.P.S. SURVEY CONTROL WHICH WAS ESTABLISHED IN PREVIOUS SURVEYS IN THE IMMEDIATE AREA BY THIS OFFICE, IN ADDITION TO THE RECOVERED MONUMENTS FOUND FROM RECORDED SURVEY NUMBER 6576 I TIED AND SET THE MONUMENTS AS SHOWN HEREON. THE RIGHT-OF-WAY FOR FOOTHILL ROAD WAS NOT LOCATED ON THIS SURVEY.

Surveyed by:  
**FARBER & SONS, INC.**  
 dba FARBER SURVEYING  
 (541) 664-5599  
 PO BOX 5286  
 431 OAK STREET  
 CENTRAL POINT, OREGON 97502

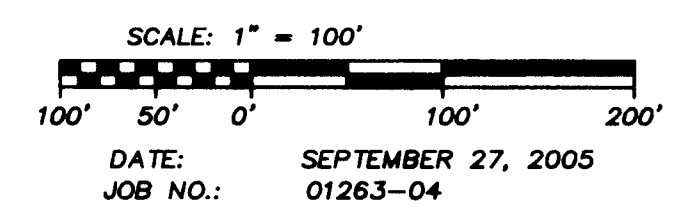

DRAWING FILE: JOBS\MEDFORD\_NE\WARD PROPERTY\MICROSURVEY\WARD\_TENTATIVE.FLX