




EXHIBIT 'A'

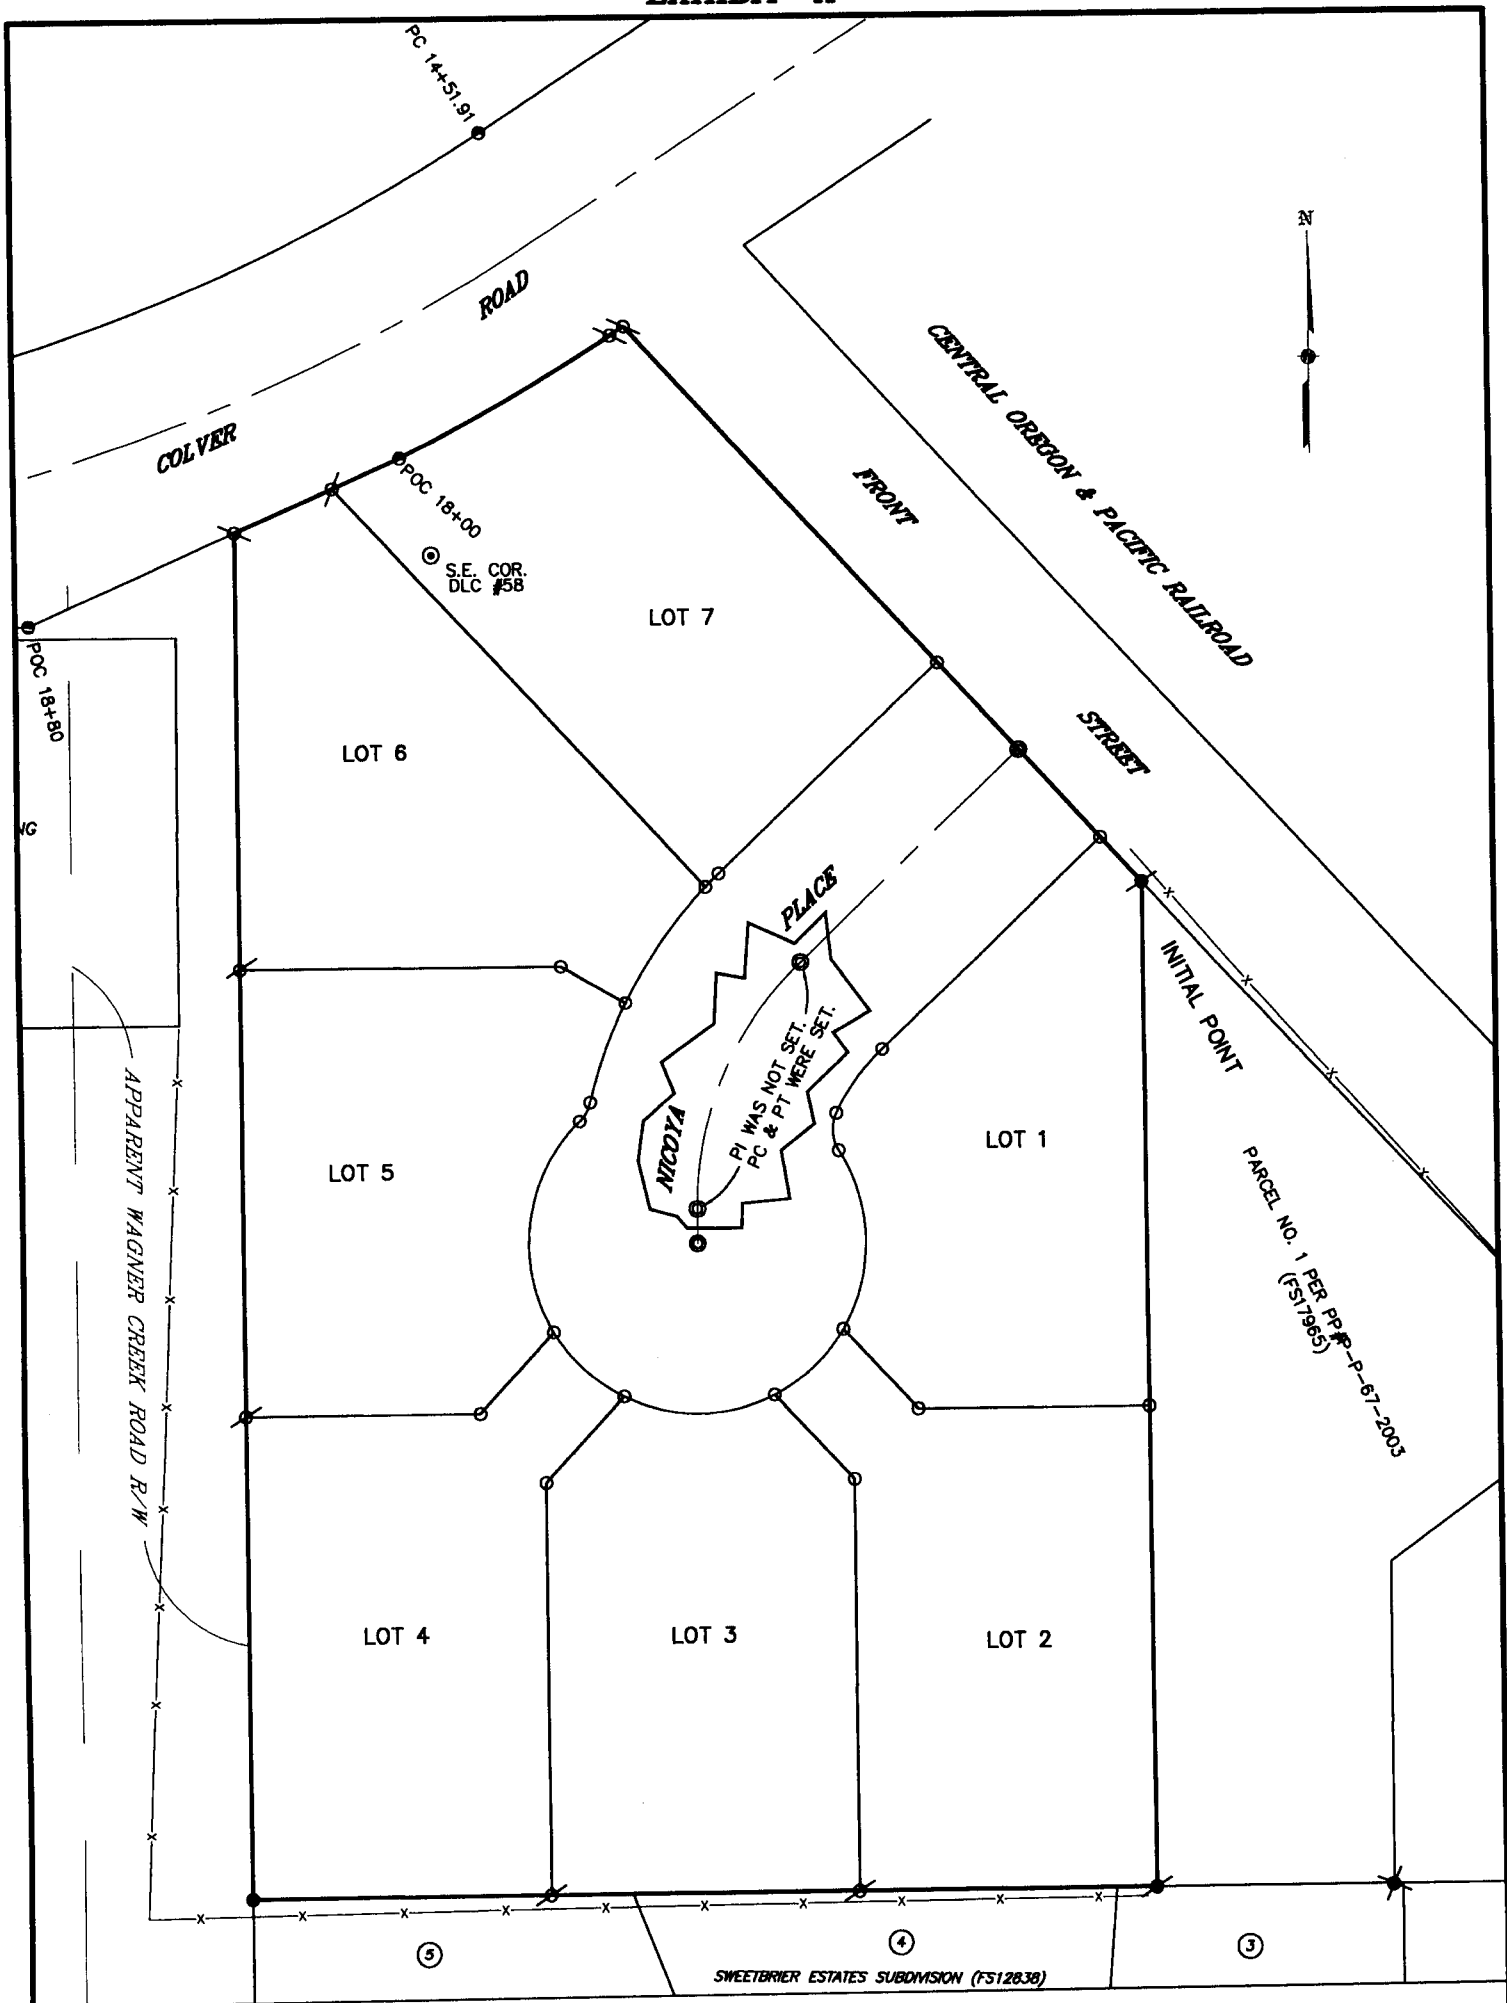

⊙ = SET 5/8" X 30" IRON PIN W/ ALUMINUM CAP MKD. L.J. FRIAR & ASSOC.

REGISTERED  
PROFESSIONAL  
LAND SURVEYOR

*James E. Hibbs*

OREGON  
JULY 17, 1986  
JAMES E. HIBBS  
2234  
RENEWAL DATE 6-30-07

TITLE:  
POST MONUMENT SKETCH  
GREEN ACRES

FOR: GREY HECHT  
P.O. BOX 442  
TALENT, OR 97540



L.J. FRIAR & ASSOCIATES P.C.  
CONSULTING LAND SURVEYORS  
816 W. 8TH ST., MEDFORD, OR.  
(541) 772-2782  
ljfriar@charter.net

DATE:  
20 MAR 2006

SCALE:  
1 inch : 40 feet


DRAWN BY: JEH  
CHK BY:

ORIGIN:

ROTATION: 0°  
JOB#: 04245FM



EXHIBIT 'A'

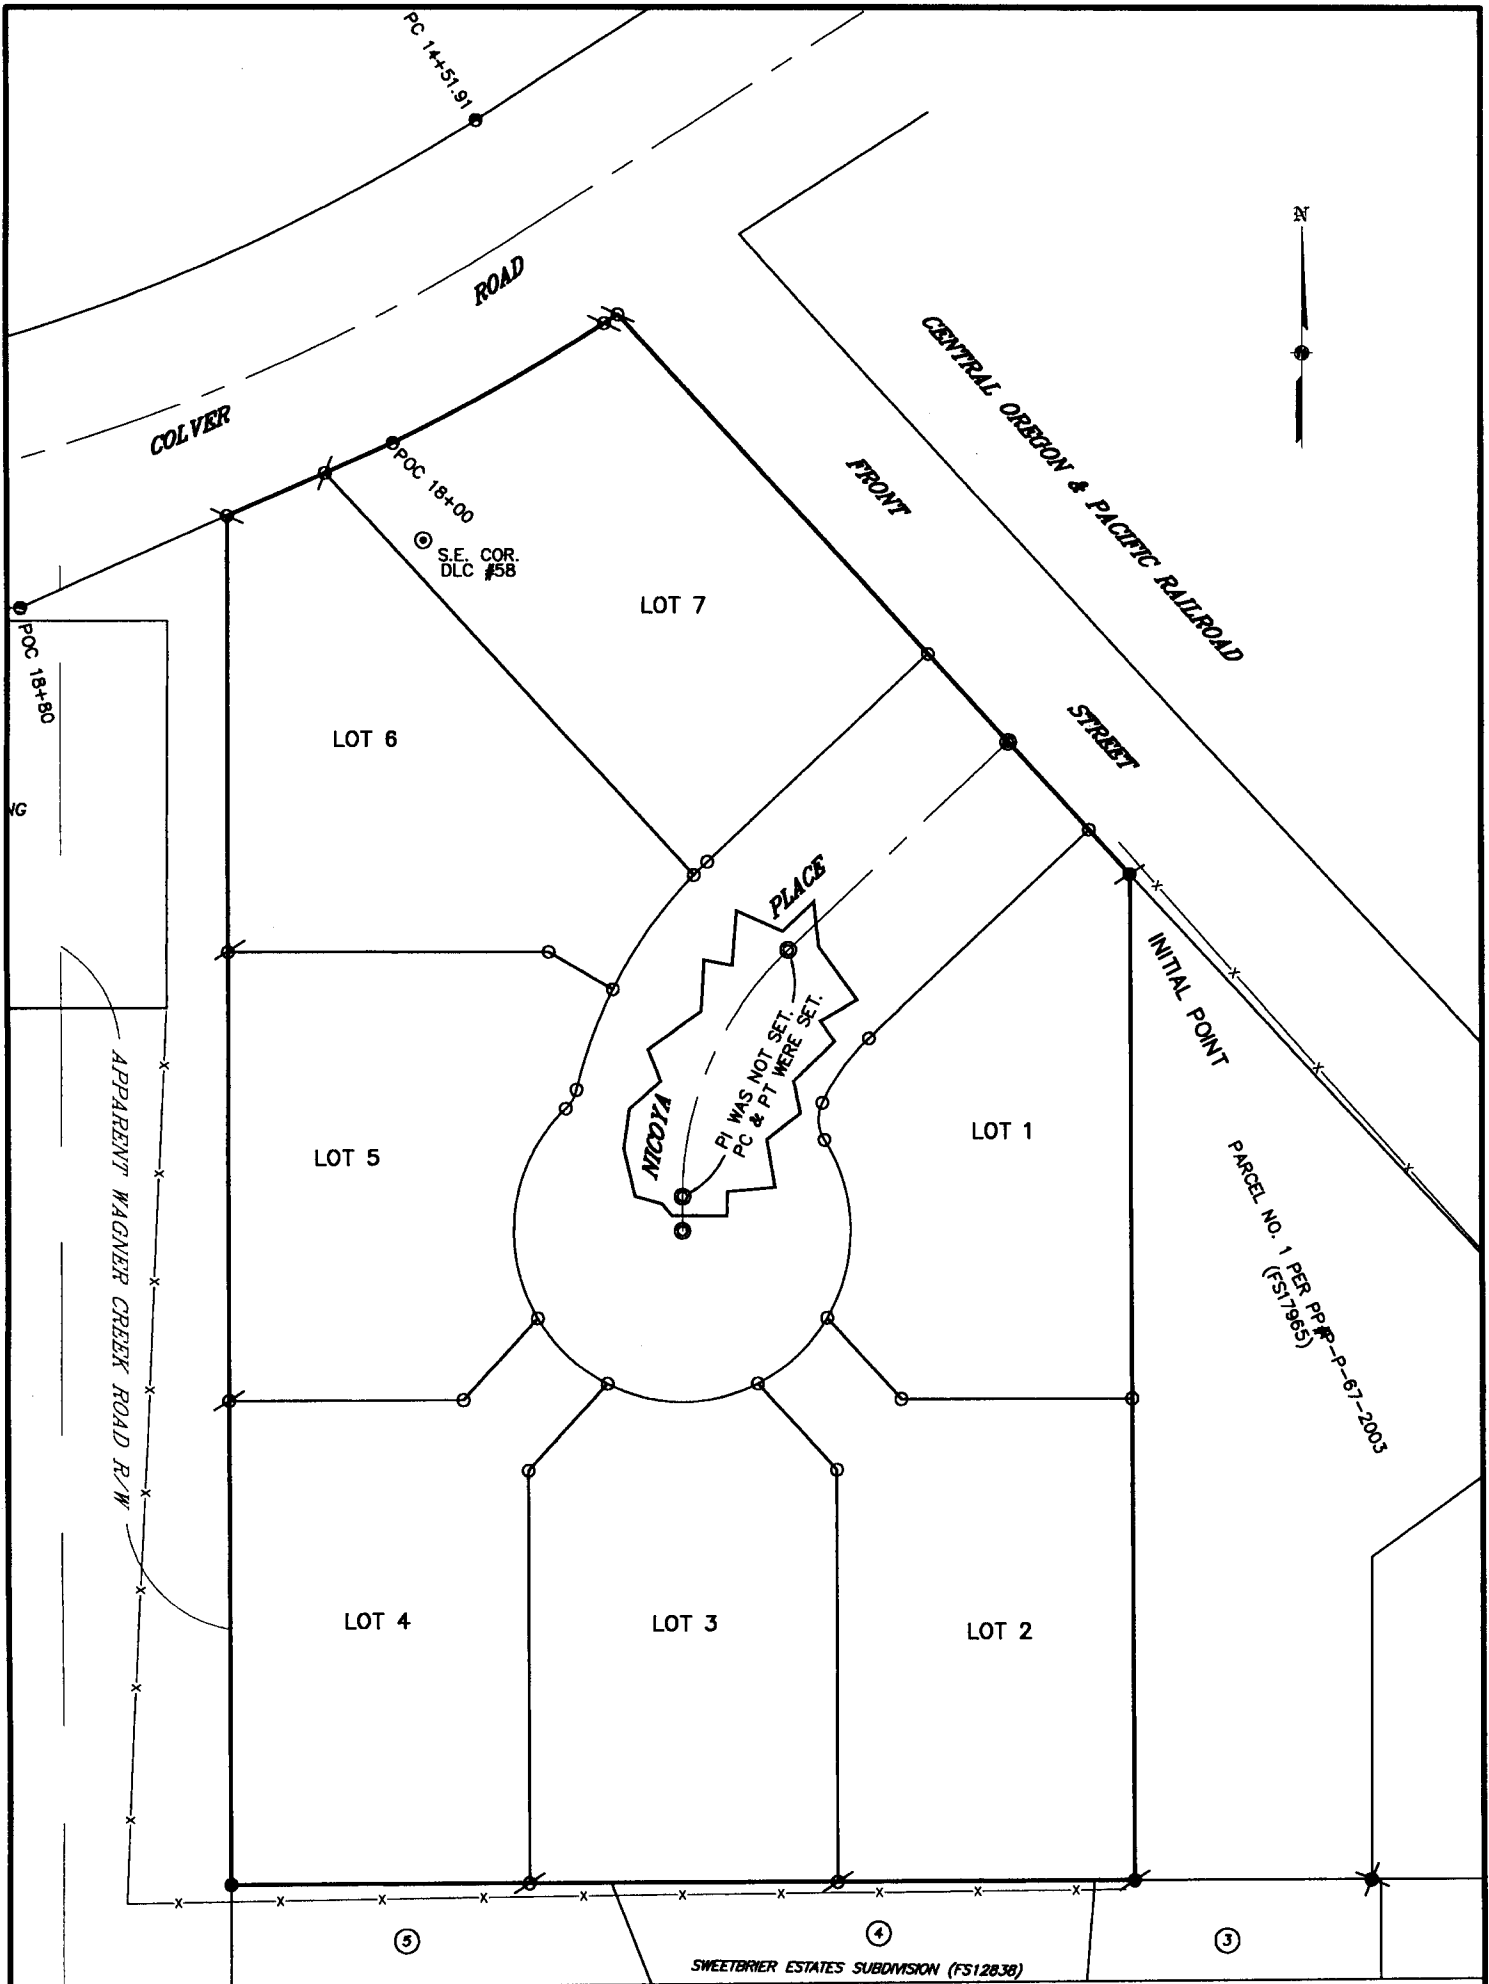

⊙ = SET 5/8" X 30" IRON PIN W/ ALUMINUM CAP MKD. L.J. FRIAR & ASSOC.

REGISTERED  
PROFESSIONAL  
LAND SURVEYOR

*James E. Hibbs*


OREGON  
JULY 17, 1986  
JAMES E. HIBBS  
2234

RENEWAL DATE 6-30-07

TITLE:  
POST MONUMENT SKETCH

GREEN ACRES

FOR: GREY HECHT  
P.O. BOX 442  
TALENT, OR 97540

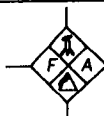

L.J. FRIAR & ASSOCIATES P.C.  
CONSULTING LAND SURVEYORS

816 W. 8TH ST., MEDFORD, OR.  
(541) 772-2782  
ljfriar@charter.net

DATE:  
20 MAR 2006

SCALE:  
1 inch : 40 feet

DRAWN BY: JEH  
CHK BY:

ORIGIN:

ROTATION: 0°  
JOB#: 04245FM

Sheet 1 of 1.