

**SURVEY FOR:**

Scott Folin  
and  
Vern Garvin  
c/o Scott Folin  
9468 Ramsey Road  
Gold Hill, OR. 97525

**LOCATION:**


S.E. 1/4 of Section 19 and  
the N.E. 1/4 of Section 30,  
T.35S.,R.2W., W.M.,  
Jackson County, Oregon

**SURVEY BY:**

Kaiser Surveying  
19440 Highway 62  
Eagle Point, OR. 97524

**DATE:**

January 31, 2006

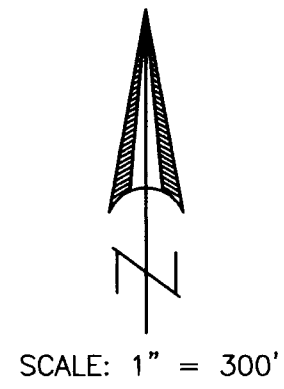

**LEGEND**

- = Found 5/8" Rebar with Plastic Cap - S.N. 15423
- = Set 5/8" x 24" Rebar with Plastic Cap marked "KAISER RLS 803"

REGISTERED  
PROFESSIONAL  
LAND SURVEYOR

*J. D. K.*

OREGON  
JULY 16, 1967  
GARY D. KAISER  
No. 803  
EXP. 6-30-07

**\*\*RECEIVED\*\***  
Date 5-11-06 By BB  
This survey consists of:  
1 sheet(s) Map  
0 page(s) Narrative  
JACKSON COUNTY  
SURVEYOR

ADJUSTED TAX LOT No.  
352W 19 - 400  
CORRECTED DEED  
INST. No.  
2006-019654 O.R.

ADJUSTED TAX LOT No.  
352W 19 - 501  
CORRECTED DEED  
INST. No. 2006-019655 O.R.

ADJUSTED TAX LOT No.  
352W 19 - 604  
CORRECTED DEED  
INST. No. 2006-019657 O.R.

ADJUSTED TAX LOT No. 352W 30 - 100 & 200  
CORRECTED DEED INST. No. 2006-019656 O.R.

**SURVEY NARRATIVE TO COMPLY WITH O.R.S. 209.250**

**PURPOSE:** To correct Property-Line-Adjustment Survey (County file No. 96-592-PA), Filed Survey No. 15423. Part of Tax Lot Nos. 352W 30 - 100 & 200 (2.78 Ac.±) was added to Tax Lot No. 352W 19 - 501 and an equal amount (2.78 Ac.±) was taken from Tax Lot No. 352W 19 - 400 and added to Tax Lot No. 352W 19 - 604. An error was made on S.N. 15423 in the field tie to the monument set for the S.E. corner of the tract taken from Tax Lot Nos. 100 & 200 and added to Tax Lot No. 501. This error was corrected as reflected on the annexed map and the deeds were corrected for tax lots 100, 200, 400, 501 & 604.

**PROCEDURE:** Information on Filed Survey No. 15423 was used to perform this Survey.

