

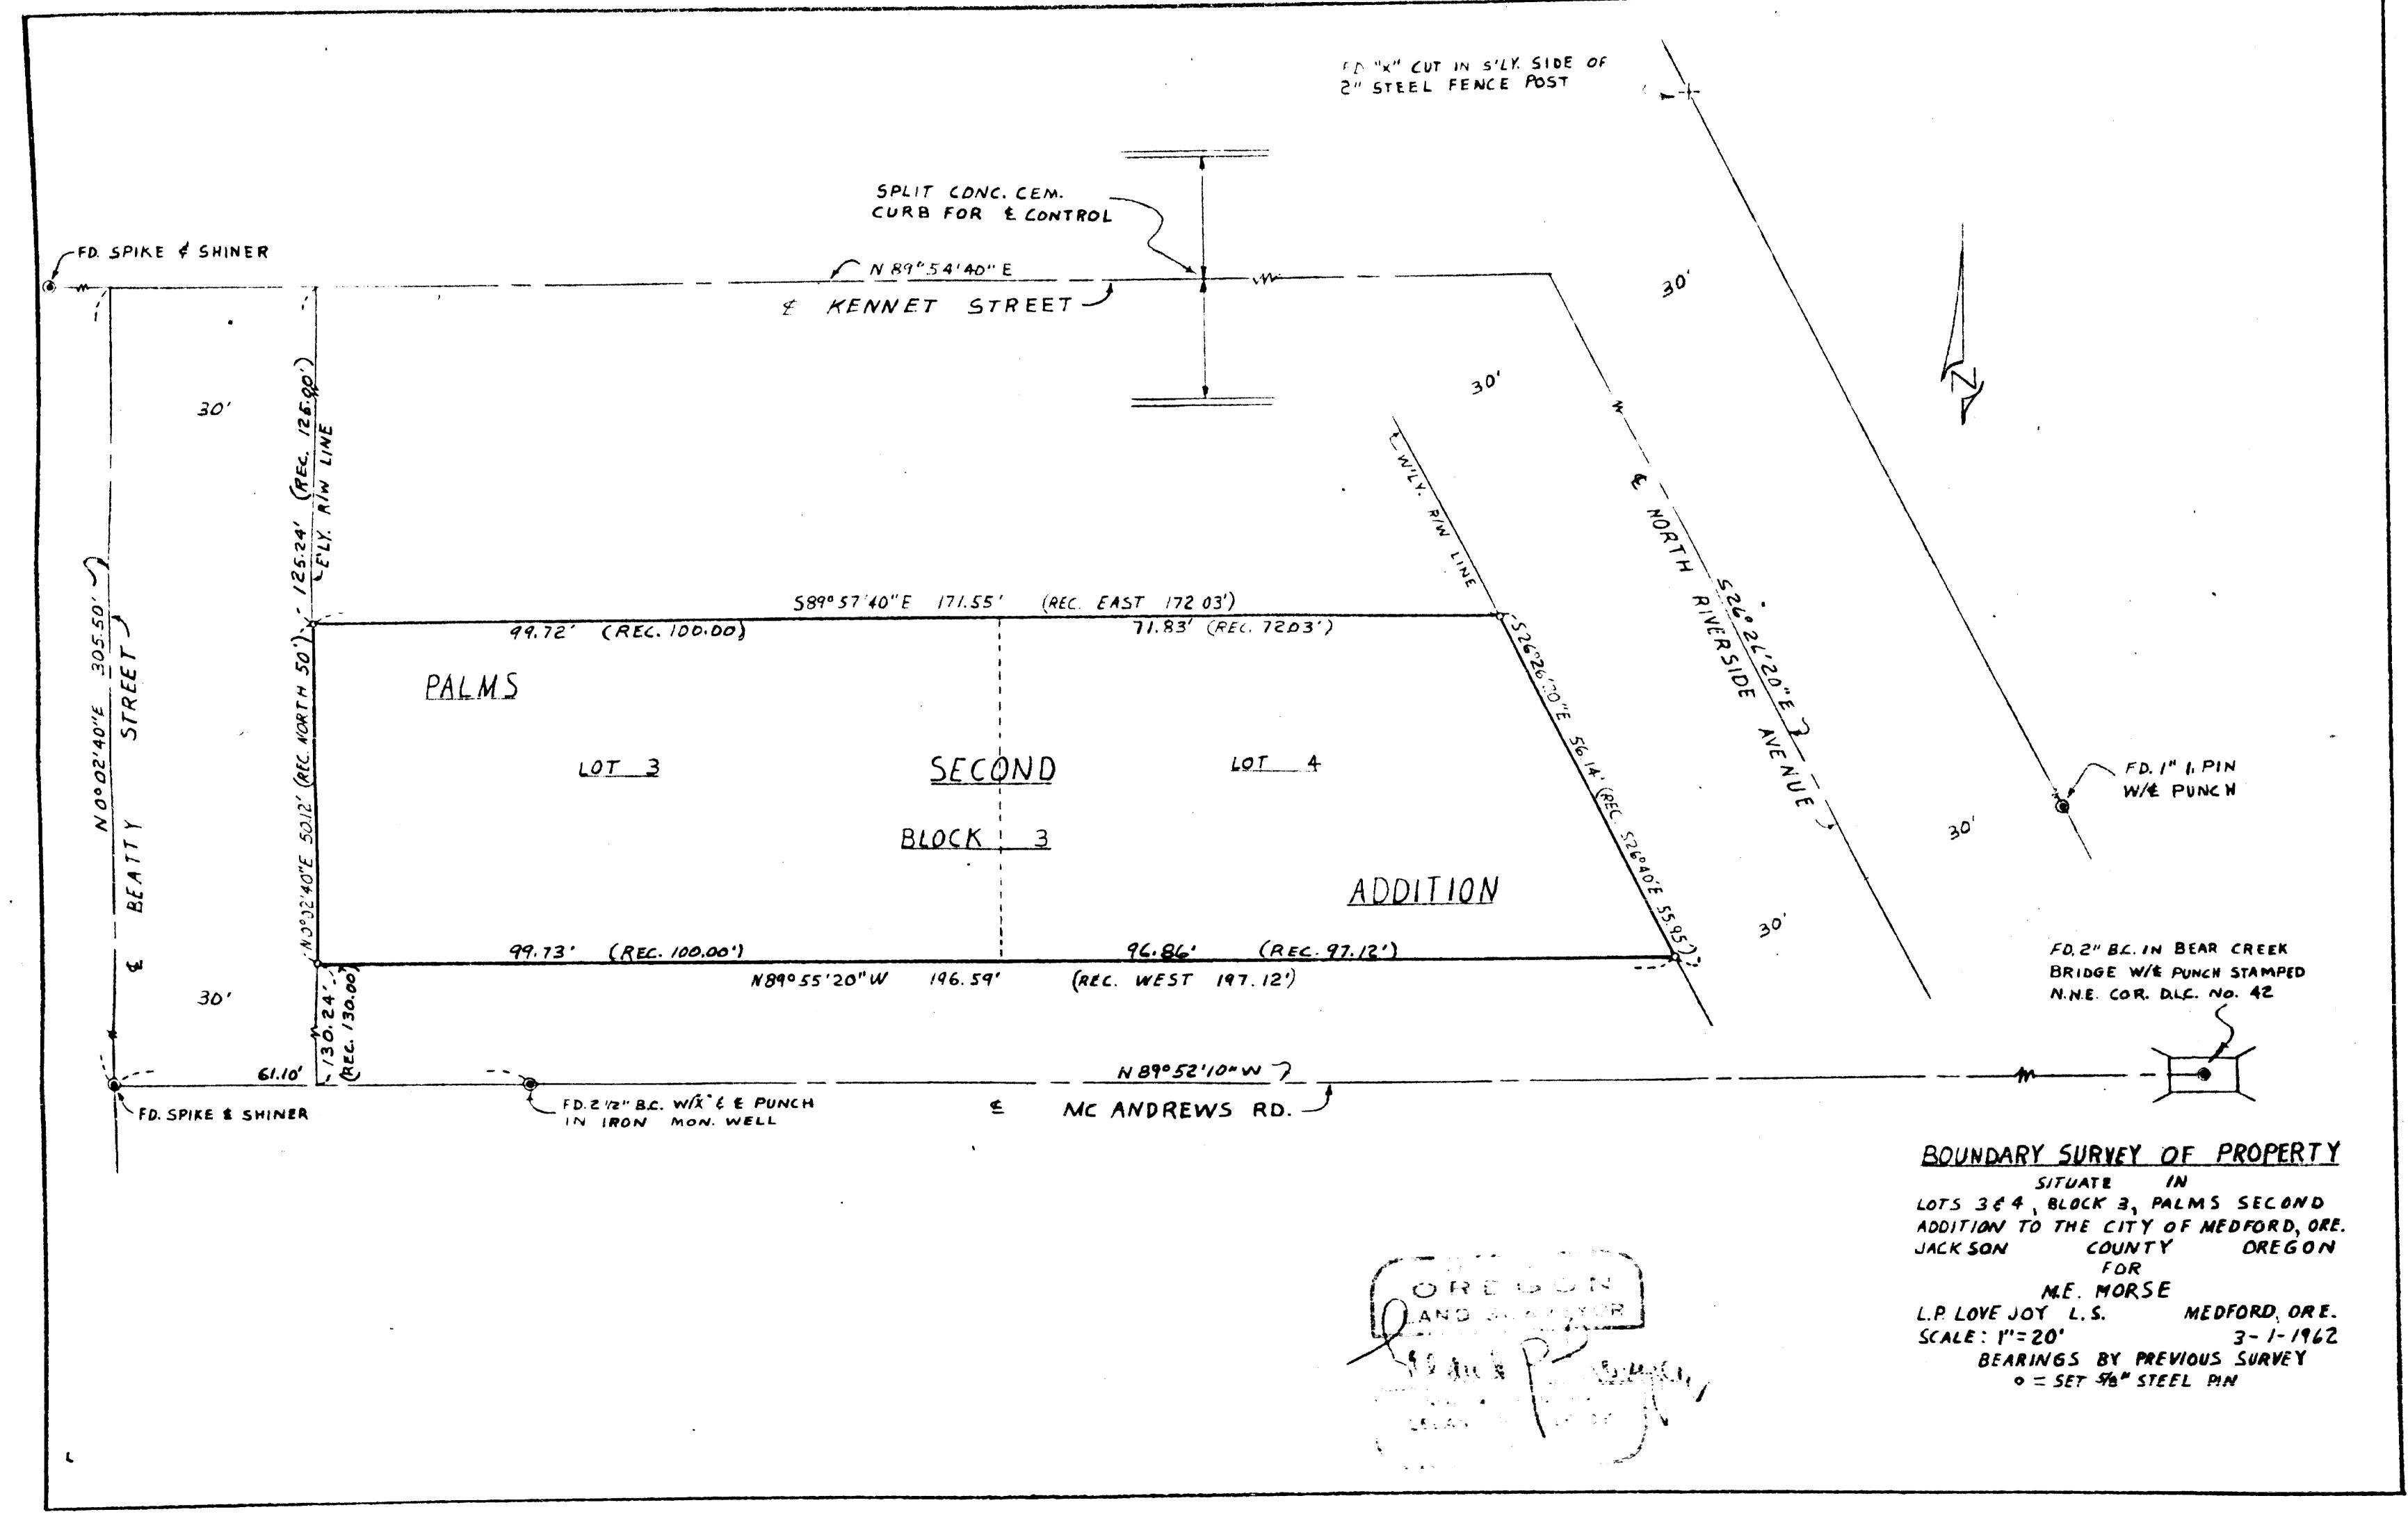

## SURVEY NARRATIVE TO COMPLY WITH SECTION 87-330

## 1947 OREGON STATE LAWS

SURVEY FOR:

M. E. Morse

1511 North Riverside Avenue.

Medford, Oregon

PURPOSE OF SURVEY: To establish property corners.

SURVEY LOCATION:

Lots 3 and 4, Block 3, PALM'S ADDITION

to the City of Medford, Oregon.

SURVEY PROCEDURE:

Found N. NE corner D.L.C. No. 42, Township 37 South, Range 1 West, Willamette Meridian, also corners on Recorded Surveys No's 137, 819, 1732 and other surveys and used as basis for survey control. Ran out boundary perimeter of Block 3, said PALM'S ADDITION and proportioned deficiency footage under record. Set 5/8" steel pins as shown.

Leland P. Lovejoy Registered Land Surveyor Work completed March 10, 1962

