

MAP OF SURVEY PROPERTY LINE ADJUSTMENT

located in the
SOUTHEAST ONE QUARTER OF SECTION 5,
TOWNSHIP 37 SOUTH, RANGE 1 WEST,
WILLAMETTE MERIDIAN, JACKSON COUNTY, OREGON
for
BRENT and CINDY CONNOR

2265 COKER BUTTE ROAD
MEDFORD, OREGON 97504

LEGEND

- ✕ = FOUND 2 1/2" BRASS CAP - SECTION CORNER
- ⋈ = FOUND 2 1/2" BRASS CAP-1/4 SECTION CORNER
- = FOUND 5/8" IRON PIN, PER S/N 2208
- ⊙ = FOUND 3/4" IRON PIN, AS NOTED
- = SET 5/8" x 24" IRON PIN w/ YELLOW PLASTIC CAP MARKED "FARBER PLS 2189"
- S/N = RECORD FILED SURVEY NUMBER
- W.M. = WITNESS MONUMENT


- BASIS OF BEARING IS TRUE NORTH, NAD 83/91 DATUM, AS DERIVED BY GLOBAL POSITIONING SYSTEM OBSERVATIONS.
 - RECORD SURVEY DATA IS SHOWN IN PARENTHESIS ADJACENT TO MEASURED SURVEY DATA WHERE APPLICABLE.
 - INST. No. = INSTRUMENT NUMBER AS RECORDED IN THE OFFICIAL RECORDS OF JACKSON COUNTY, OREGON.

SURVEY NARRATIVE TO COMPLY WITH O.R.S. 209.250

PURPOSE: TO SURVEY AND MONUMENT THE PARCELS AS APPROVED BY JACKSON COUNTY ROADS, PARKS AND PLANNING SERVICES FILE NO. SUB2005-00044, DATED OCTOBER 5, 2005.

PROCEDURE: UTILIZING CONTROL ESTABLISHED IN THIS SURVEY, I TIED THE CORNERS SHOWN HEREON. USING THESE TIES AND THE DEED RECORDS, OF INSTRUMENT NUMBERS 98-25176 AND 05-038407 OF THE OFFICIAL RECORDS OF JACKSON COUNTY, OREGON. I WAS ABLE TO RETRACE THE BOUNDARIES OF THE SUBJECT PROPERTIES AND FOUND THE RECOVERED CORNERS TO BE WITHIN EXPECTED STANDARDS. I THEN COMPUTED THE LOCATIONS OF THE ADJUSTED BOUNDARY AND SET PINS AT THE LOCATIONS SHOWN.

Surveyed by:
FARBER & SONS, INC.
dba FARBER SURVEYING
(541) 664-5599
PO BOX 5286
431 OAK STREET
CENTRAL POINT, OREGON 97502

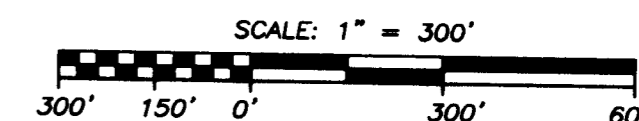

DATE: March 17, 2006
 JOB NO.: 1318-05
 DRAWING FILE: JOBS\mfr ne\cokerbutte\microsurvey2005\pla mos 022506.DWG

1/4 CORNER FOUND
 2 1/2" BRASS DISC
 FLUSH WITH PAVEMENT
 STAMPED:
 T37S R1W
 1/4 S 5/8
 1996

RECEIVED
 DATE 5-26-06 BY [Signature]
 This survey consists of:
 1 sheet(s) Map
 2 page(s) Narrative
 JACKSON COUNTY
 SURVEYOR

APPROVED BY JACKSON COUNTY PLANNING
 FILE NUMBER SUB2005-00044
 BY: [Signature] DATE: May 24, 2006

REGISTERED
 PROFESSIONAL
 LAND SURVEYOR

[Signature]
 OREGON
 JULY 26, 1985
 HERBERT A. FARBER
 2189

RENEWAL DATE 12-31-07

